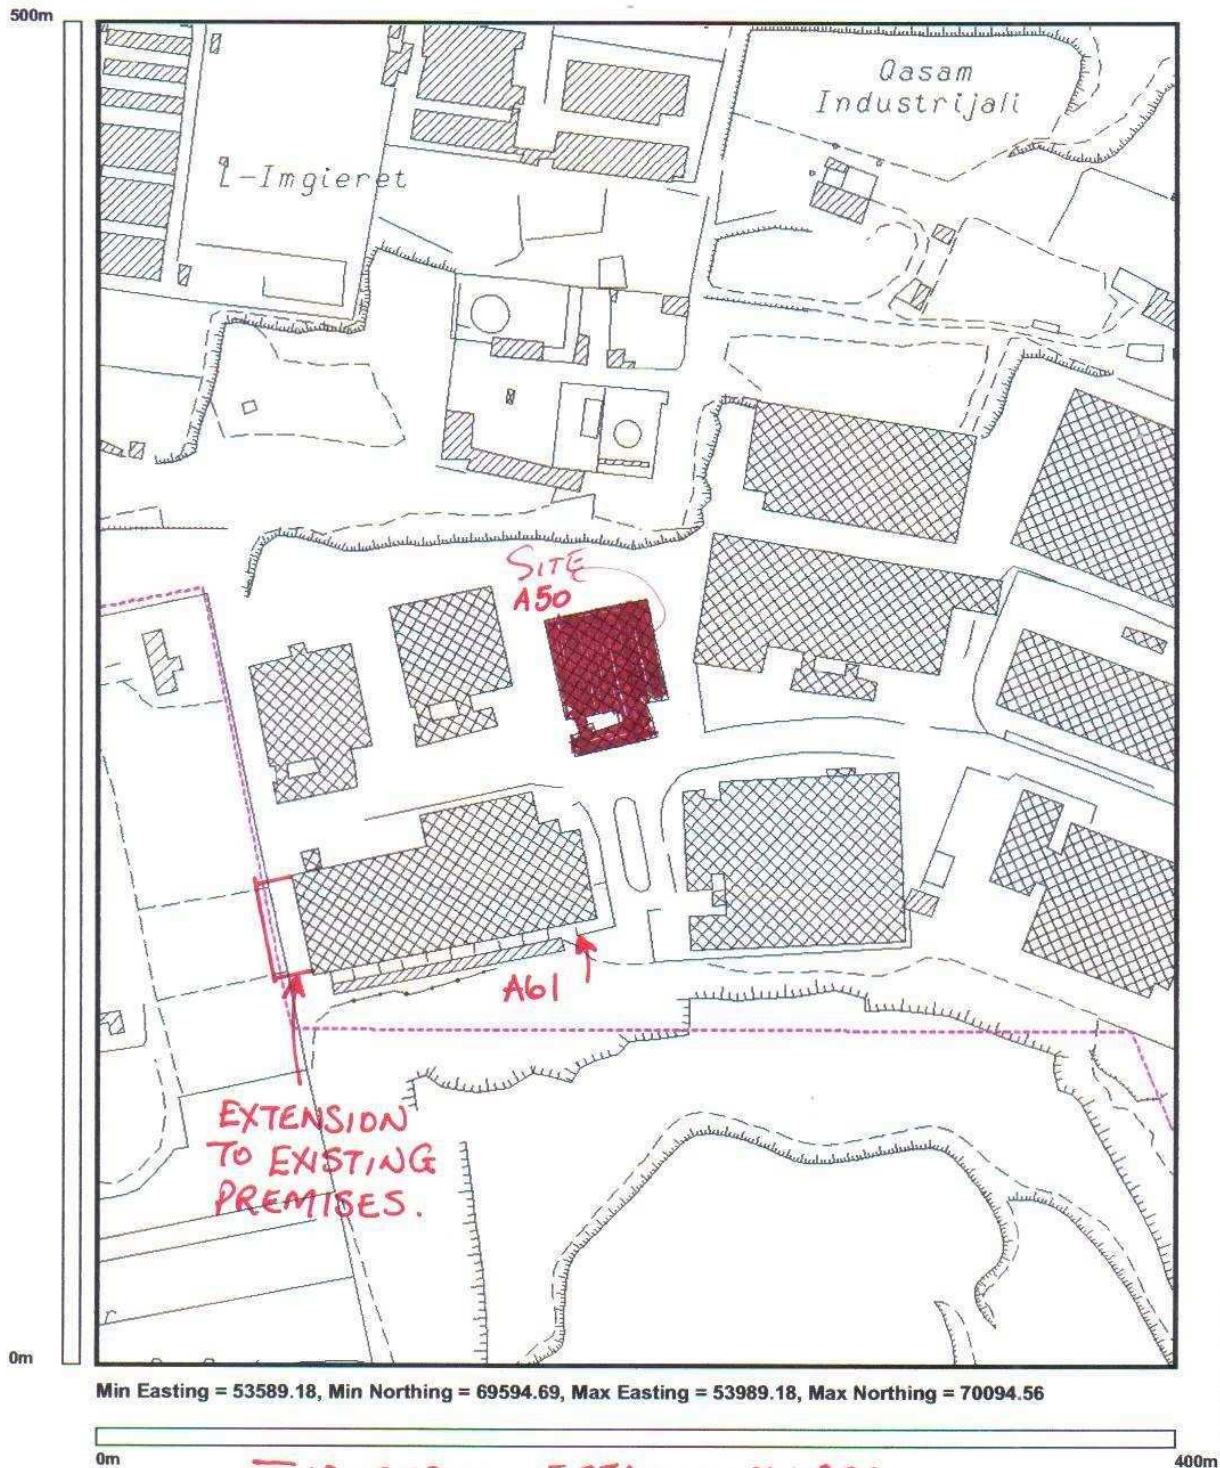

101 / AMINO

Site Map Including
both
A61 Industrial Estate, Marsa Premises
and
the Factory Extension
at
A50 Industrial Estate, Marsa

500m



INDUSTRIAL ESTATE - MARSA.

MEPA

St. Francis Ravelin
Floriana
PO Box 200, Valletta, Malta
Tel: +356 240976 Fax: +356 224846

www.mepa.org.mt

Site Plan, Scale 1:2500 Printed on: Wednesday, November 01, 2006

Not to be used for interpretation or scaling of scheme alignments

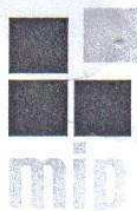
Copyright © Malta. Not for resale.

C. Vener

102 / AMINO

MIP Site Report
For
Factory
A50, Industrial Estate, Marsa

Our Reference: mra050/07



07 September 2007

Malta Environment and Planning Authority
Environment Protection Directorate
Pollution Prevention & Control Unit
C/o Quality Control Laboratory
Industrial Estate Kordin
Paola
Att. Ms Charmaine Ajao Vassallo B.Sc (Hons), M.Sc

Re: MRA050 - Site report

Dear Ms Vassallo

Amino Chemicals Ltd has requested a declaration from Malta Industrial Parks Ltd in connection with their IPPC requirement for factory MRA050 at Marsa Industrial Estate prior to operation by Amino Chemicals.

The premises in question was built in the mid 1970's and allocated on the 18th March 1976 to the them *Valletta Light Clothing* for the "*manufacturing of ladies garments*" until about 5 years ago when the company closed down. It remained empty until it was allocated to *Amino Chemicals* about a year ago "*for the manufacturing of chemicals and R&D activities*".

I trust this information is sufficient for your perusal. If you need further clarification please do not hesitate to contact me.

Yours sincerely,

Gorg Cilia
Chief Projects Officer.

cc. Mr Philip Micallef - Amino Chemicals

Malta Industrial Parks Limited

Reg. Office: UB8 San Gwann Industrial Estate, San Gwann SGN 09, Malta
Tel : +356 2541 0000 Fax : +356 2541 2541
Email : info@m-i-p.org Website : www.m-i-p.org