

C	20-08-12	L.B.	Extension to MPP
B	11-10-11	L.B.	Revised layout
A	08-02-11	R.B.	Revised boundary on big 3-rd
No.	Date	Initials	Revision Details
BEZZINA & COLE ARCHITECTS & ENGINEERS 40, St. Ignace Street, St. John's, NL A1B 1X1 Tel. (506) 212-0000, Telefax (506) 212-0001			
SANT ANTNN WASTE MANAGEMENT FACILITY			
Block Plan Showing Photo Views			
Job No.	17-05	Drawn	AL/2 3000C
File Path	MEPA-10	Scale	N.T.S.
Date	18-07-06	Drawn	R.MUSCAT
Checked	KAGUS		



PHOTO – A



PHOTO – B



PHOTO – C



PHOTO – D



PHOTO – E



PHOTO – F



PHOTO – G



PHOTO – H





PHOTO – I



PHOTO – J



PHOTO - K

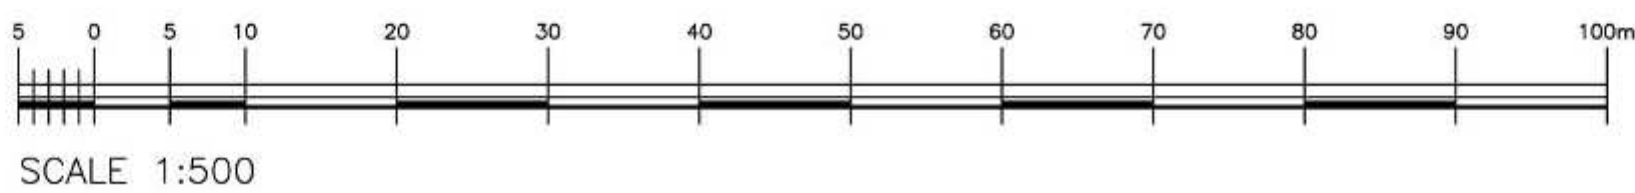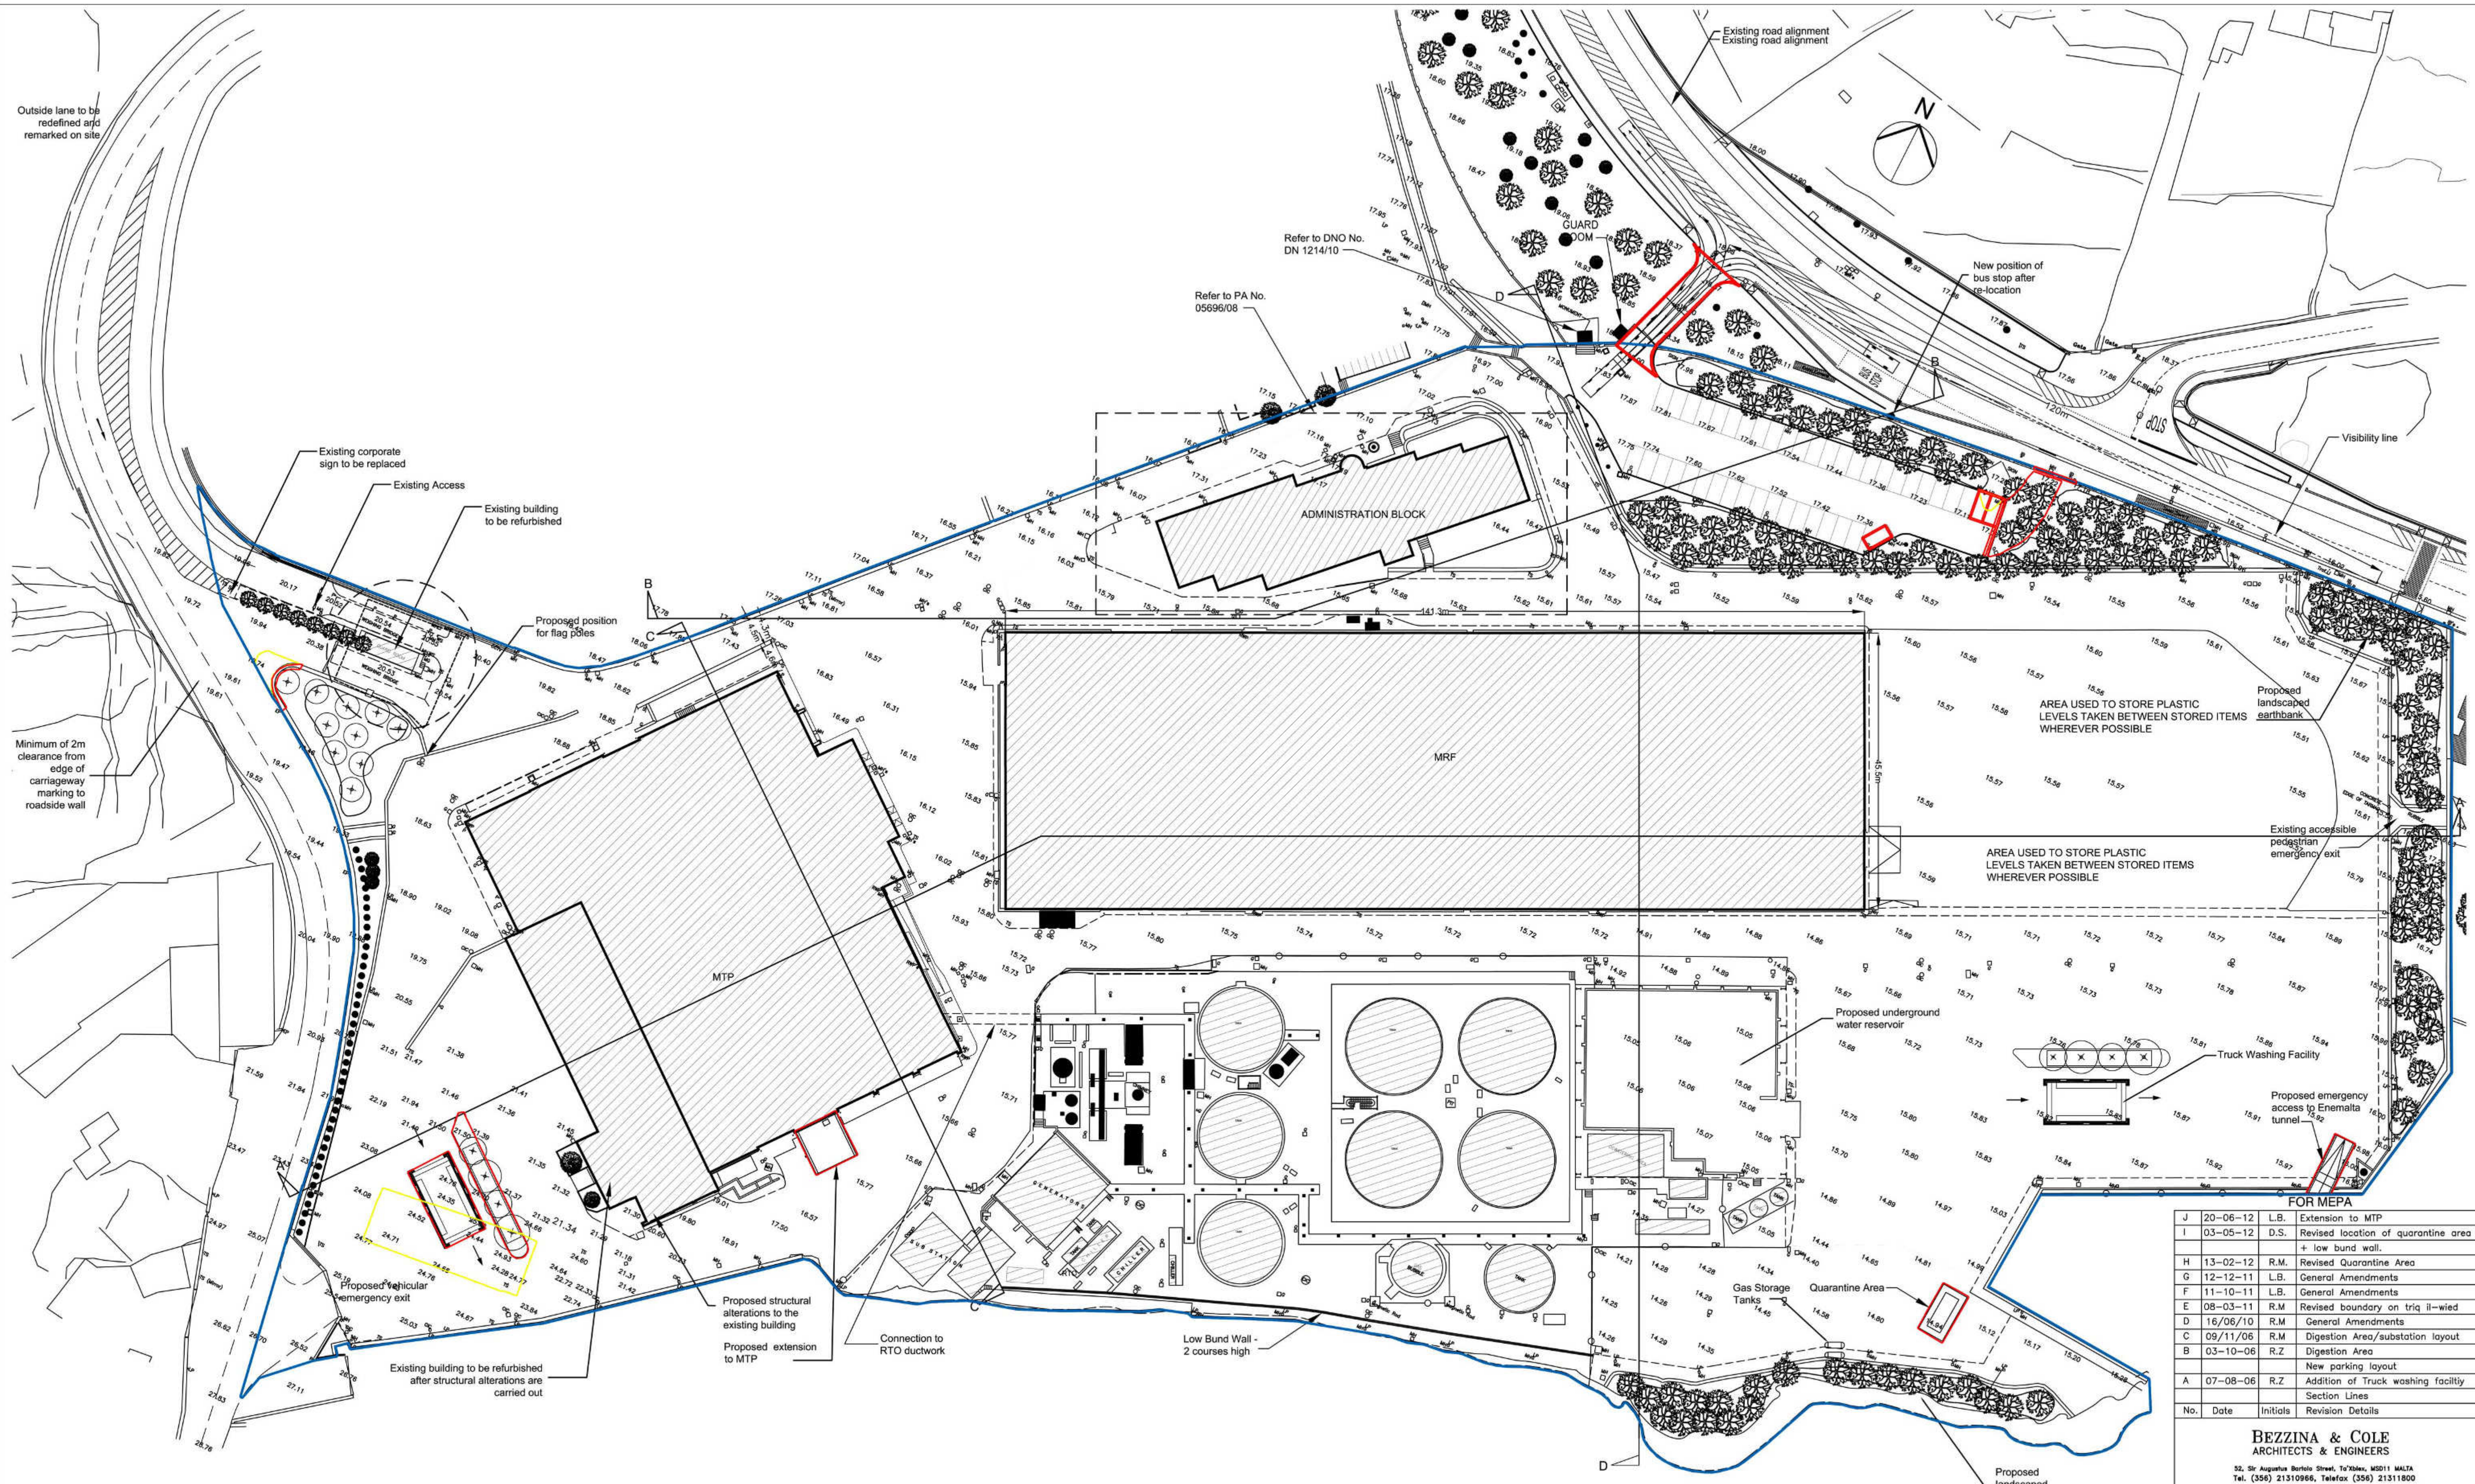

- LEGEND**
- TO BUILD
 - TO DEMOLISH


J	20-06-12	L.B.	Extension to MTP
I	03-05-12	D.S.	Revised location of quarantine area + low bund wall.
H	13-02-12	R.M.	Revised Quarantine Area
G	12-12-11	L.B.	General Amendments
F	11-10-11	L.B.	General Amendments
E	08-03-11	R.M.	Revised boundary on triq il-wied
D	16/06/10	R.M.	General Amendments
C	09/11/06	R.M.	Digestion Area/substation layout
B	03-10-06	R.Z.	Digestion Area
A	07-08-06	R.Z.	Addition of Truck washing facility
			Section Lines
No.	Date	Initials	Revision Details

BEZZINA & COLE
ARCHITECTS & ENGINEERS
52, Sir Augustus Bortolo Street, Ta' Xbiex, MS011 MALTA
Tel. (356) 21310966, Telefax (356) 21311800

Job Title
**SANT ANTNN
WASTE MANAGEMENT FACILITY**

Drawing Title
**BLOCK PLAN OF THE
PROPOSED WORKS**

Job No. 17-05	Drwg. No. AL(2)_30J
File Path MEPA-10	Drawn R.MUSCAT
Scale 1:500	Date 18-07-06
	Checked K.AGIUS


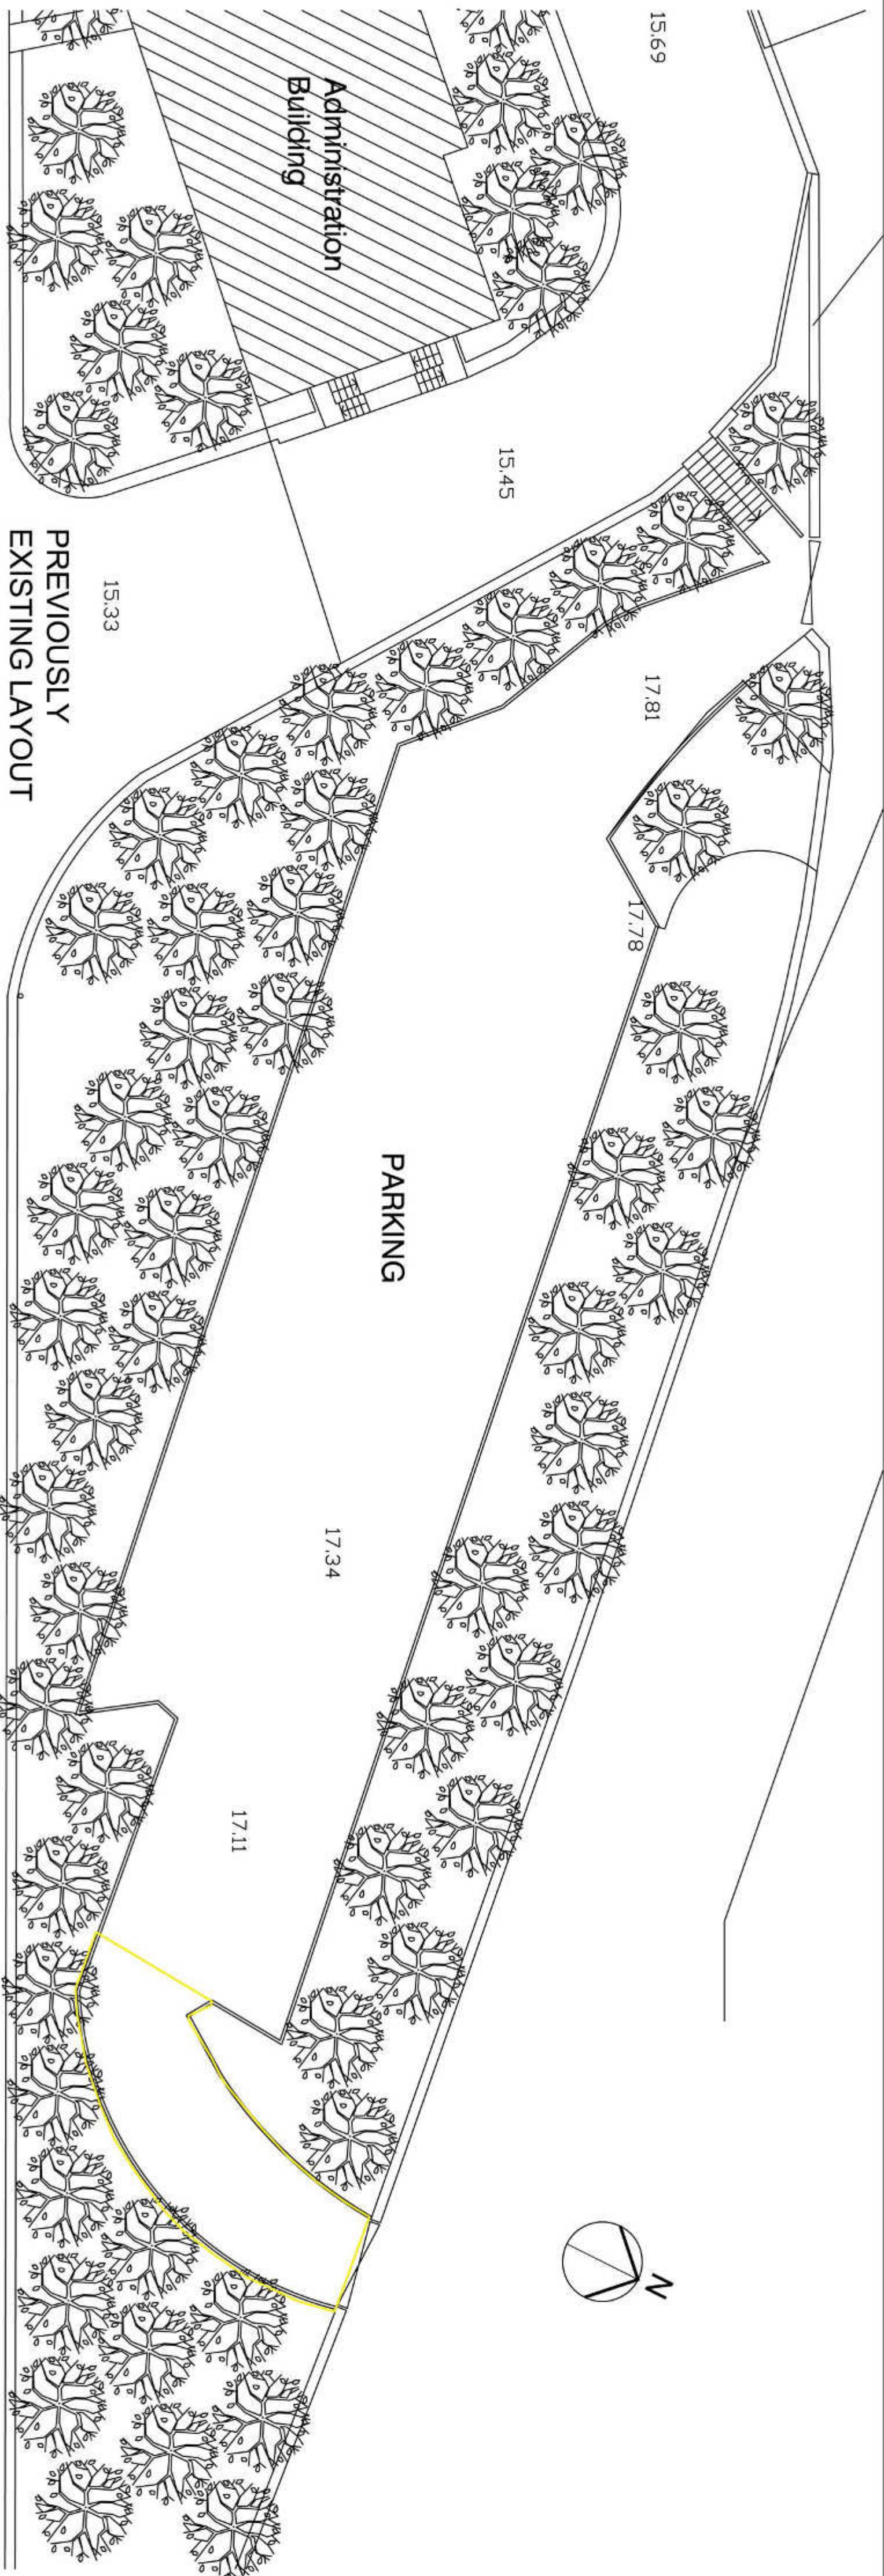


PREVIOUSLY
EXISTING LAYOUT

LEGEND

TO DEMOLISH

TO BUILD

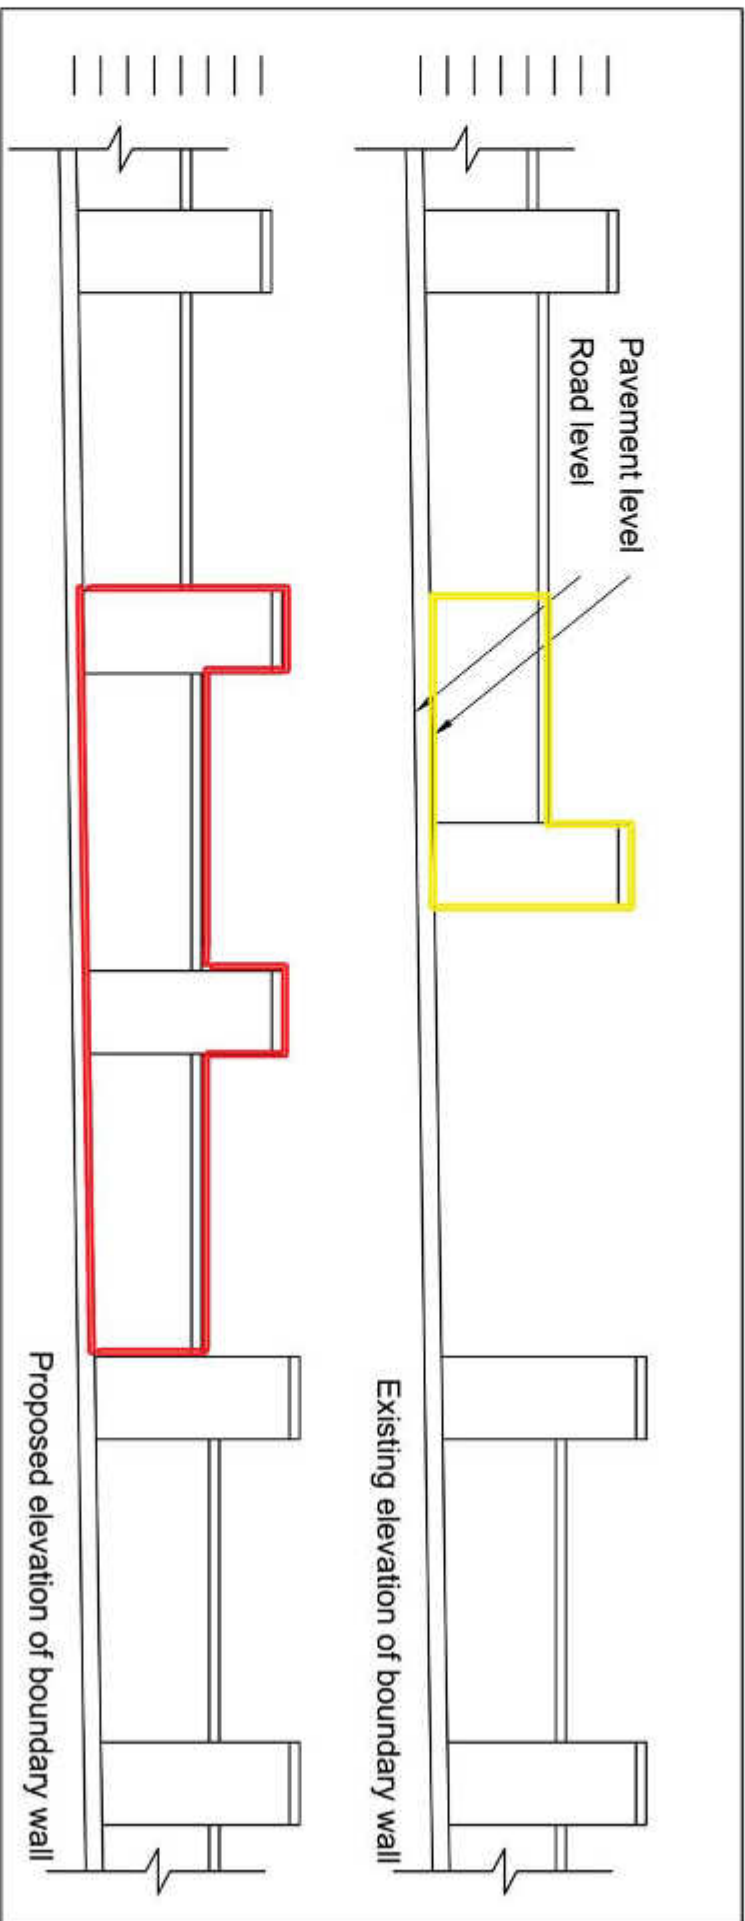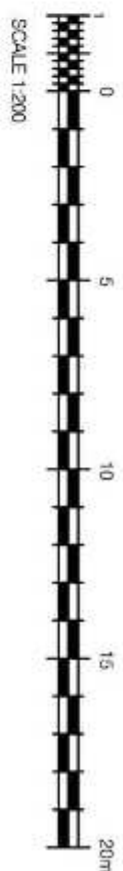

ELEVATION A - EXISTING AND PROPOSED BOUNDARY WALL
SCALE 1:75



PRESENT LAYOUT

E	23-04-12	L.B.	Additional information for TM
D	26-03-12	R.M.	Additional information for TM
C	11-10-11	L.B.	New layout
B	02-09-10	R.M.	New layout
A	05-10-06	R.Z.	New layout
No.	Date	Initials	Revision Details
BEZZINA & COLE ARCHITECTS & ENGINEERS 55 St. Lawrence Street, Suite 10700, West 1 Tel. (438) 2131066, Fax (438) 2131060			
Job Title WASTE MANAGEMENT FACILITY			
Drawing Title PREVIOUSLY EXISTING AND AS BUILT PARKING AREA			
Job No.	Drawn No.		
17-05	A/C(2-37E)		
File Path			
MEPA-10			
Scale	Date	Drawn	Checked
200	03-08-06	R.ZAMMIT	K.AGUS