

Job No.
17-05

File Path
MEPA-10

Scale
1:200

Dwg. No.
AL(2)-40C

Drawn
R.MUSCAT

Checked
K.AGIUS

MEPA DECEMBER 2011

General revision

General revision

General revision

12/12/11 L.B.

11/10/11 L.B.

16/06/10 R.M.

No. | Date | Initials | Revision Details

SANT ANTININ

WASTE MANAGEMENT FACILITY

BEZZINA & COLE

ARCHITECTS & ENGINEERS


52, St. Augustine, Birkirkba, T. 20206, M. 20211, M. 20212
Tel: (356) 21310800, (356) 21310801, (356) 21310802

PLAN AND ELEVATIONS


FOR AS BUILT MRF BUILDING

Drawing Title


MEPA DECEMBER 2011

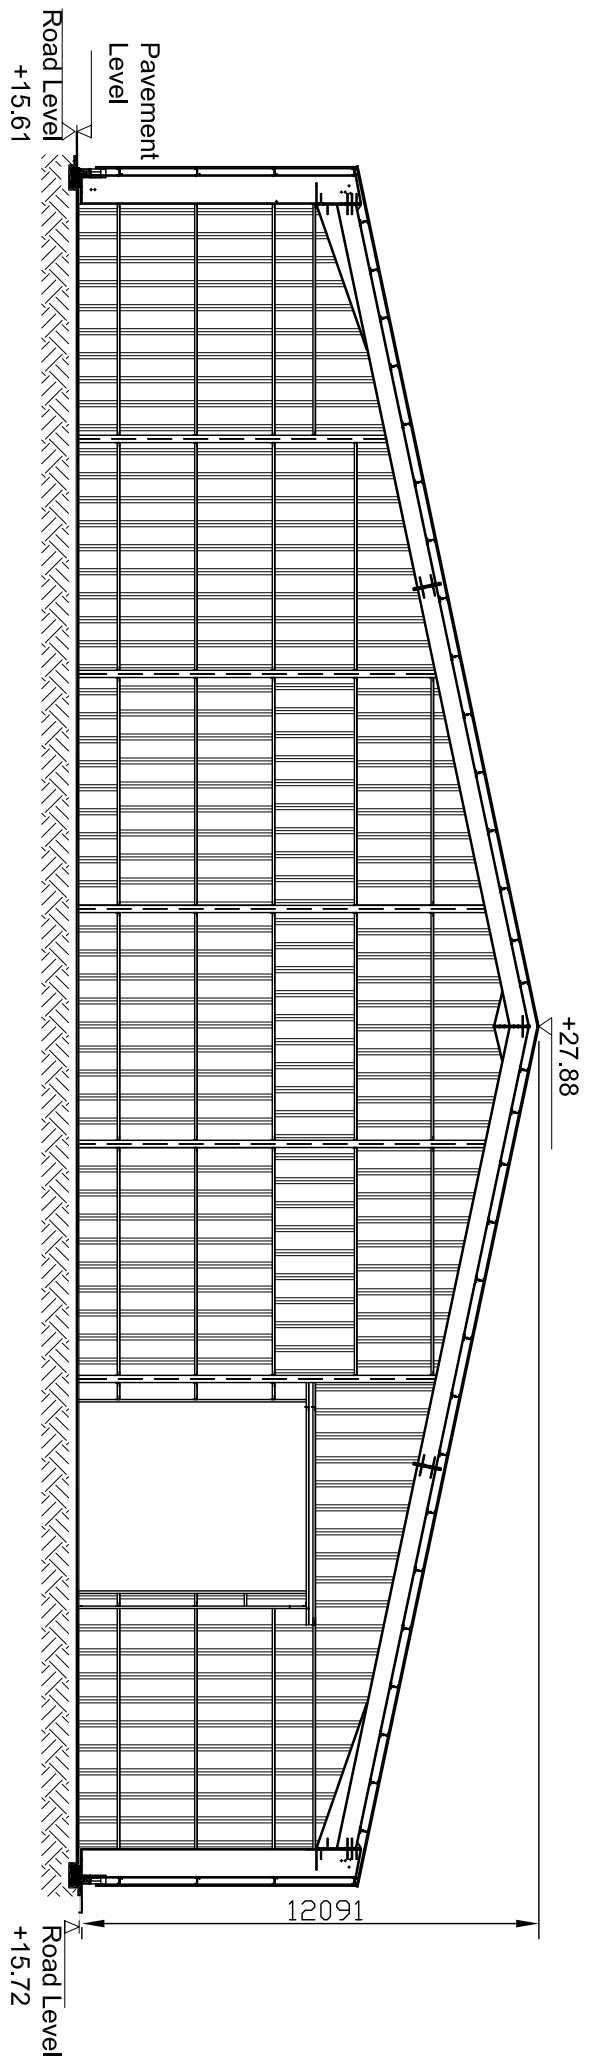

SECTION - XX

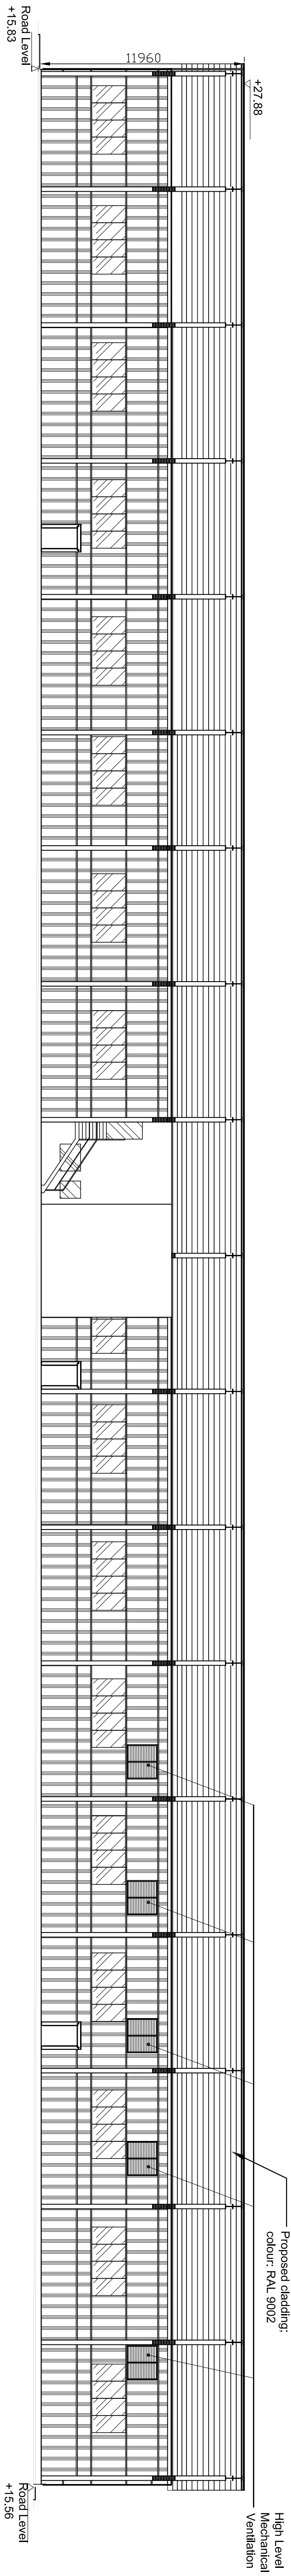

SECTION - YY

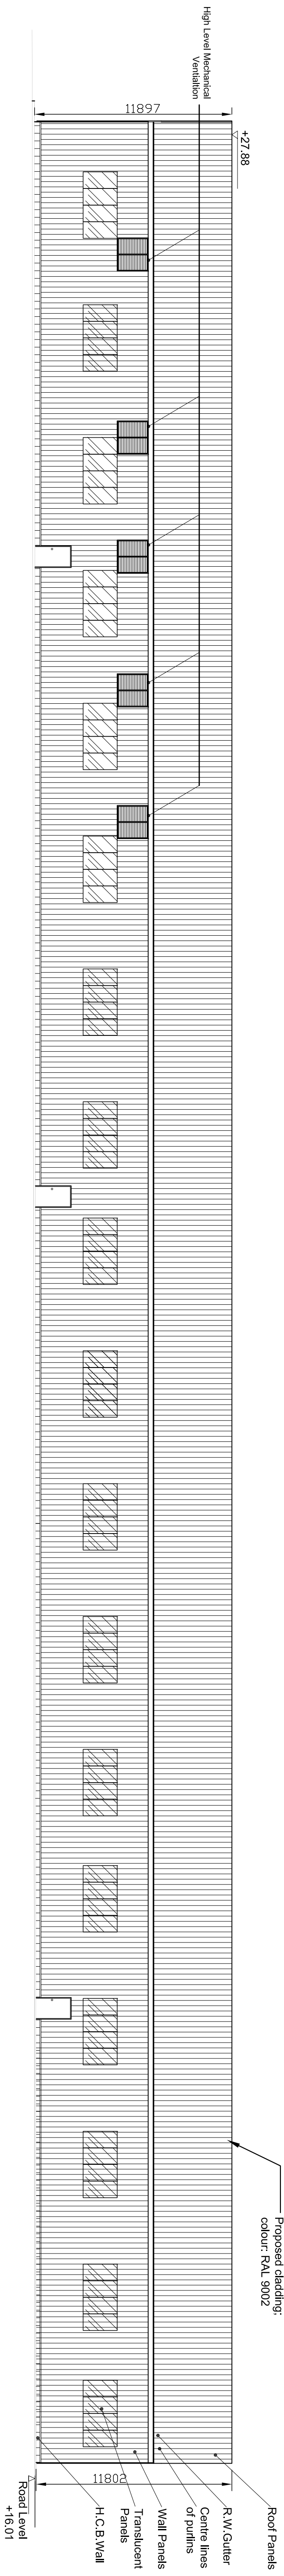

ELEVATION - C

MEPA DECEMBER 2011

C	12/12/11	L.B.	General revision
B	11/10/11	L.B.	General revision
A	16/06/10	R.M.	General revision
No.	Date	Initials	Revision Details

BEZZINA & COLE
ARCHITECTS & ENGINEERS
52, St Augustine Bvd, St Augustine, QLD 4051
Tel: (07) 21310800, Mobile: (07) 21310800


Job Title


SANT ANTNIN WASTE
MANAGEMENT FACILITY

Drawing Title


SECTIONS AND ELEVATION C
OF THE AS BUILT MRF BUILDING

Job No	17-05	Draw. No.	AL(2)-41C
File Path	MEPA-10	Drawn	R.MUSCAT
Scale	1:200	Date	04-08-06
		Checked	K.AGUS

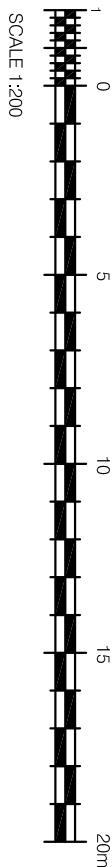

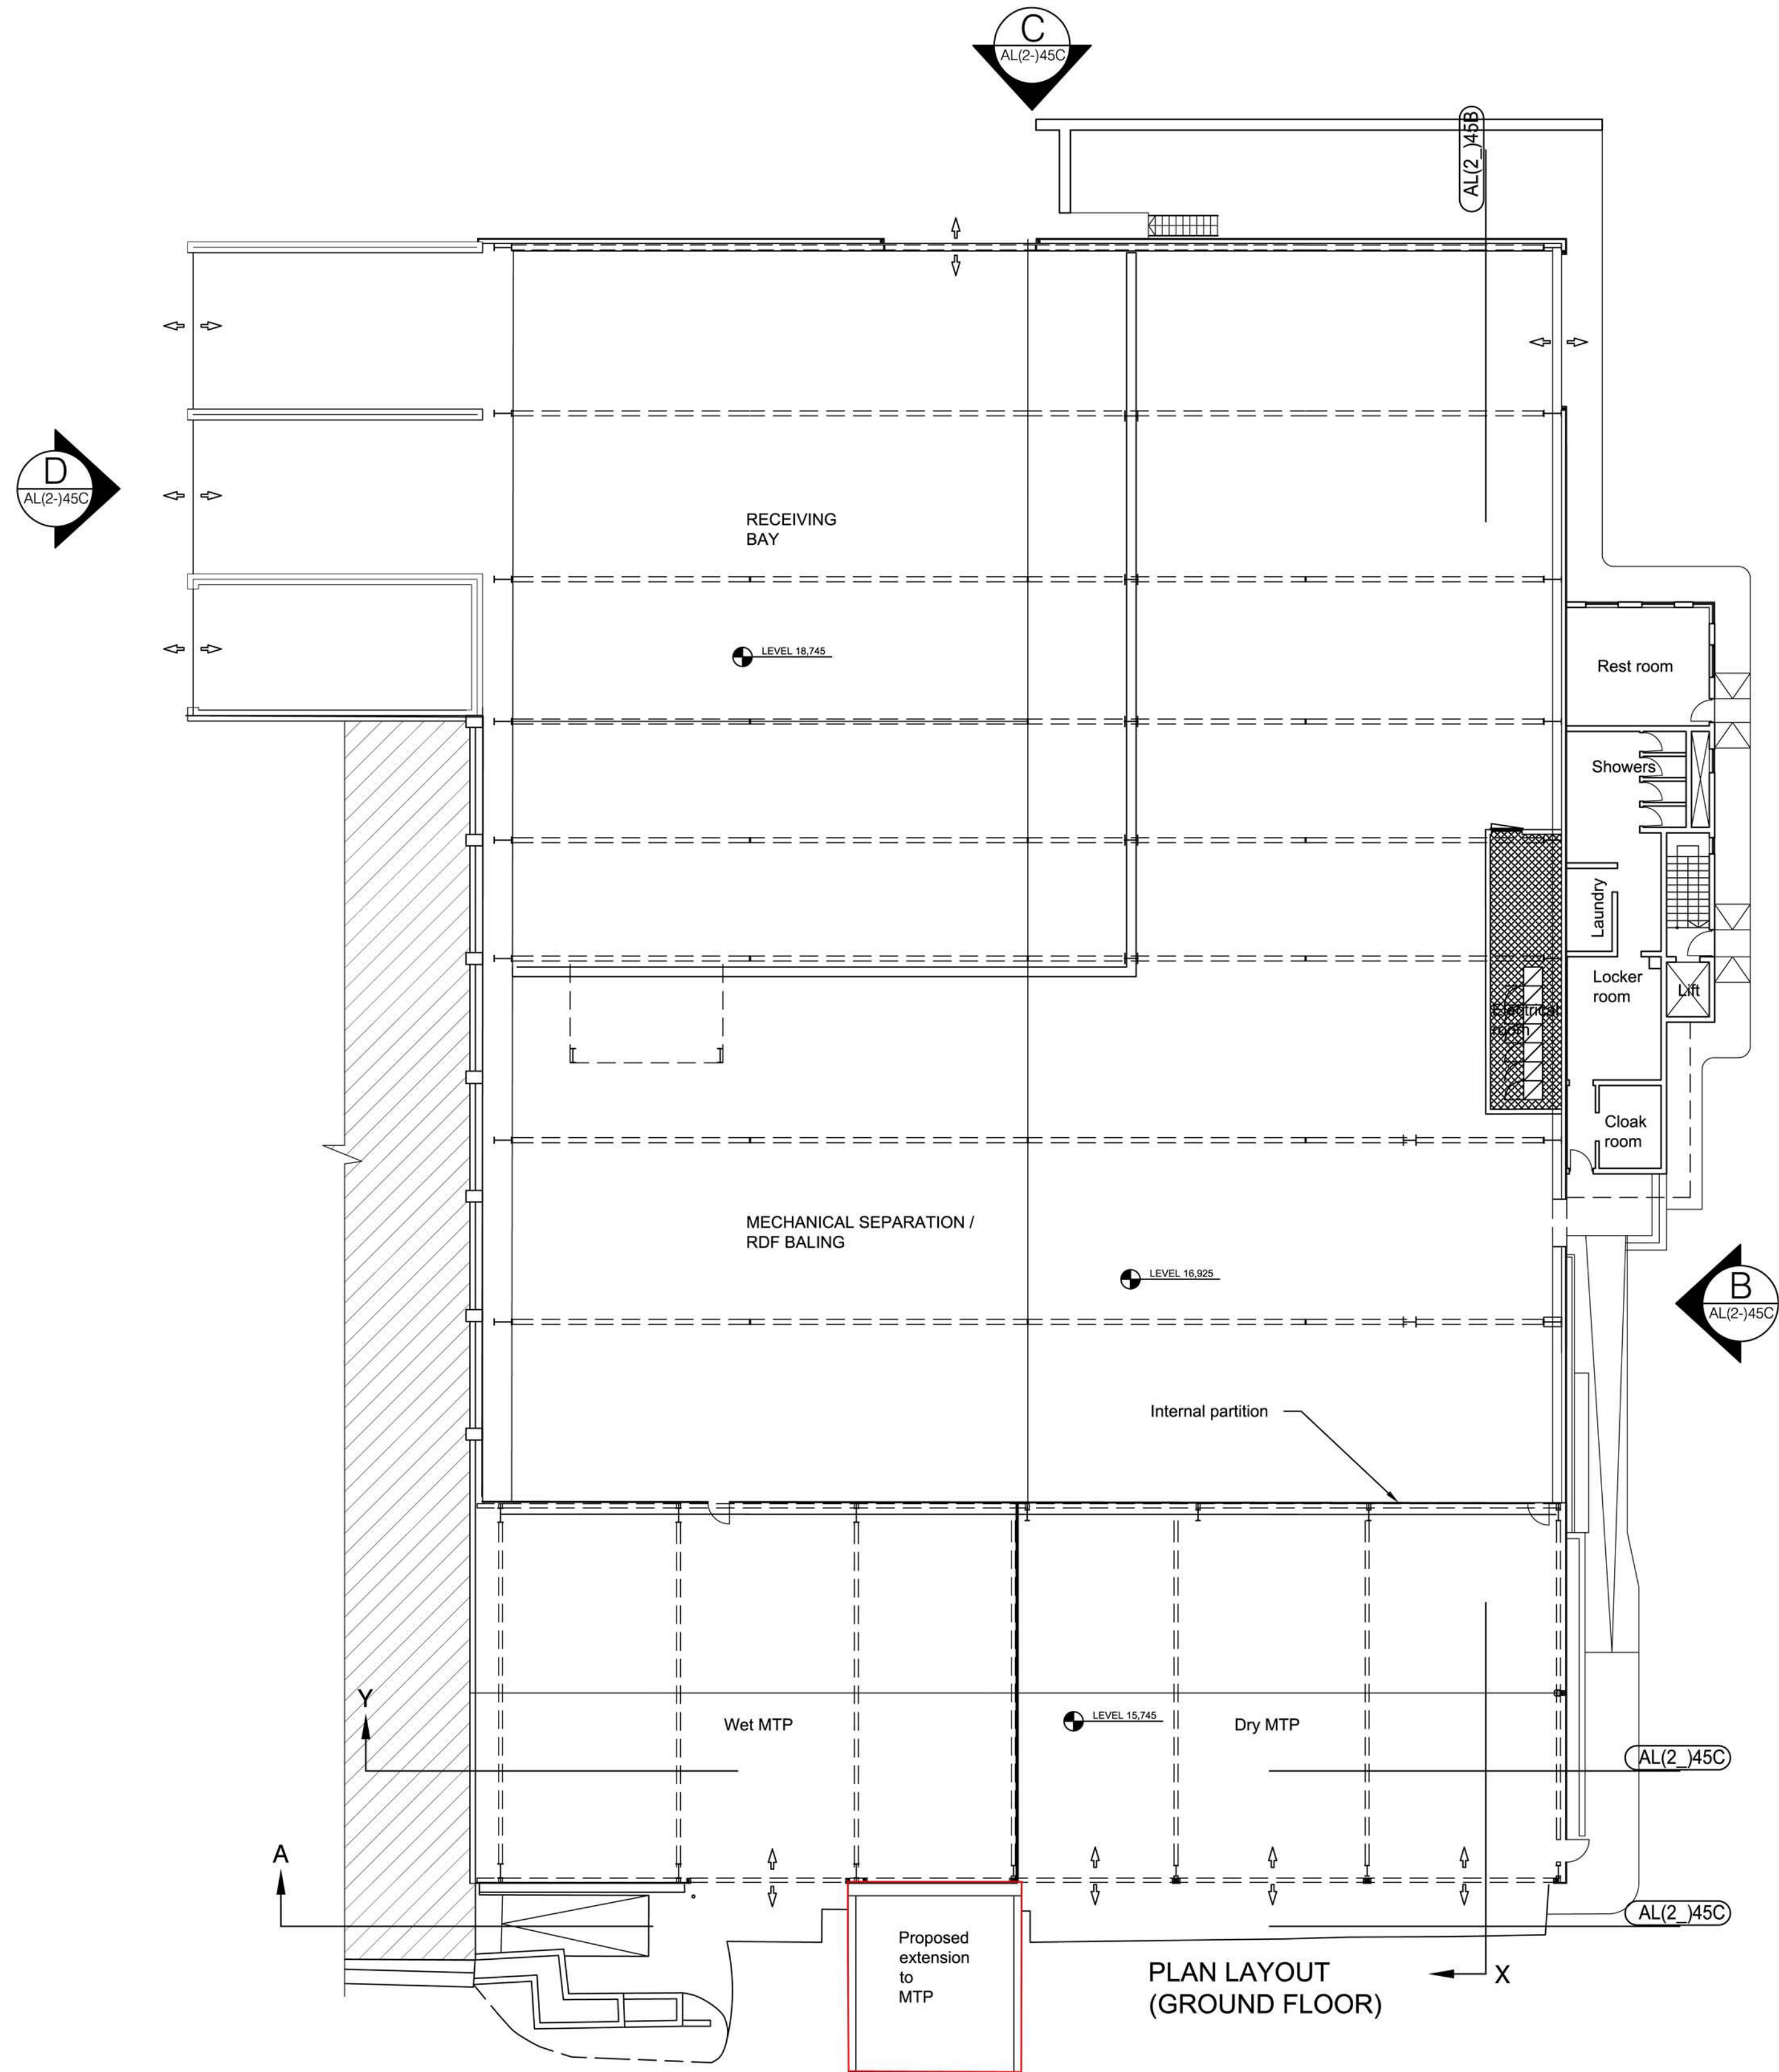

PLAN LAYOUT
(GROUND FLOOR)

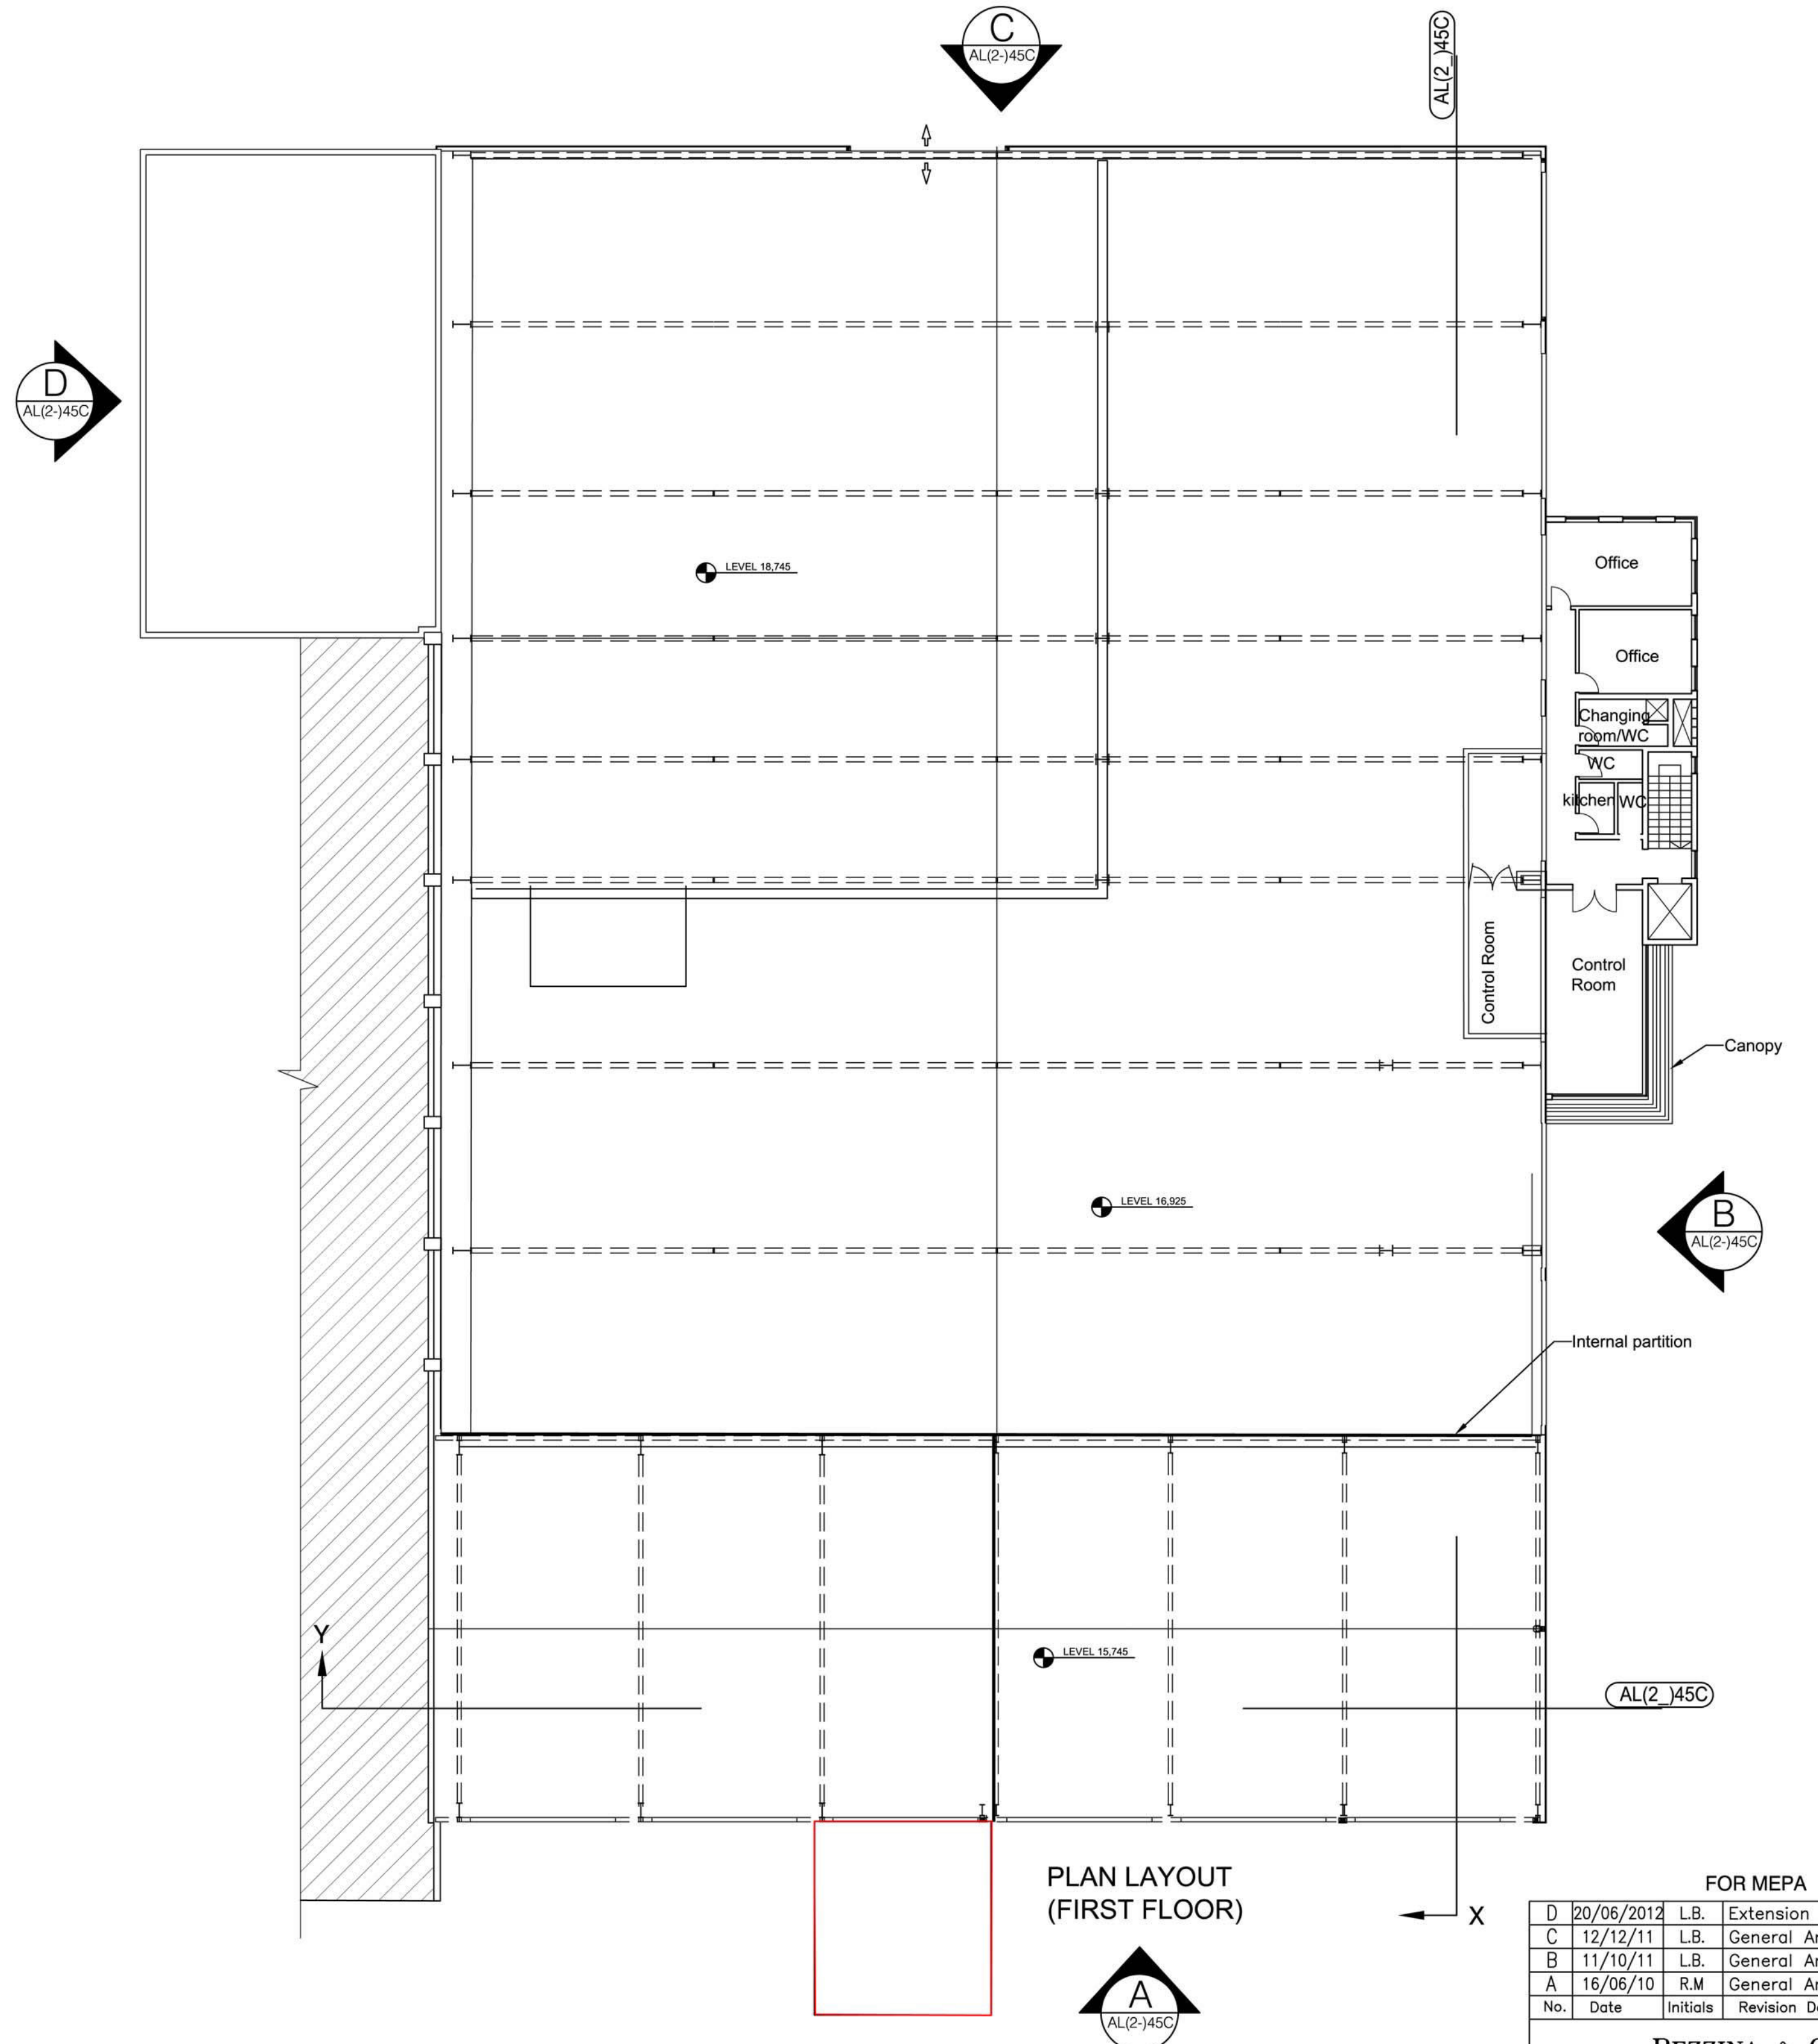

PLAN LAYOUT
(FIRST FLOOR)


FOR MEPA				
D	20/06/2012	L.B.	Extension to MTP	
C	12/12/11	L.B.	General Amendments	
B	11/10/11	L.B.	General Amendments	
A	16/06/10	R.M.	General Amendments	
No.	Date	Initials	Revision Details	

BEZZINA & COLE
ARCHITECTS & ENGINEERS
52, St. Augustine Barrolo Street, Ta'Xbiex, MSD11 MALTA
Tel. (356) 21310966, Telefax (356) 21311800


Job Title
**SANT ANTIN WASTE
MANAGEMENT FACILITY**

Drawing Title
**AS BUILT PLAN LAYOUT OF THE
MECHANICAL TREATMENT PLANT
(MTP)**


Job No. 17-05		Drwg. No. AL(2_)44D	
File Path MEPA-10			
Scale 1:200	Date 04-08-06	Drawn R.MUSCAT	Checked K.AGIUS

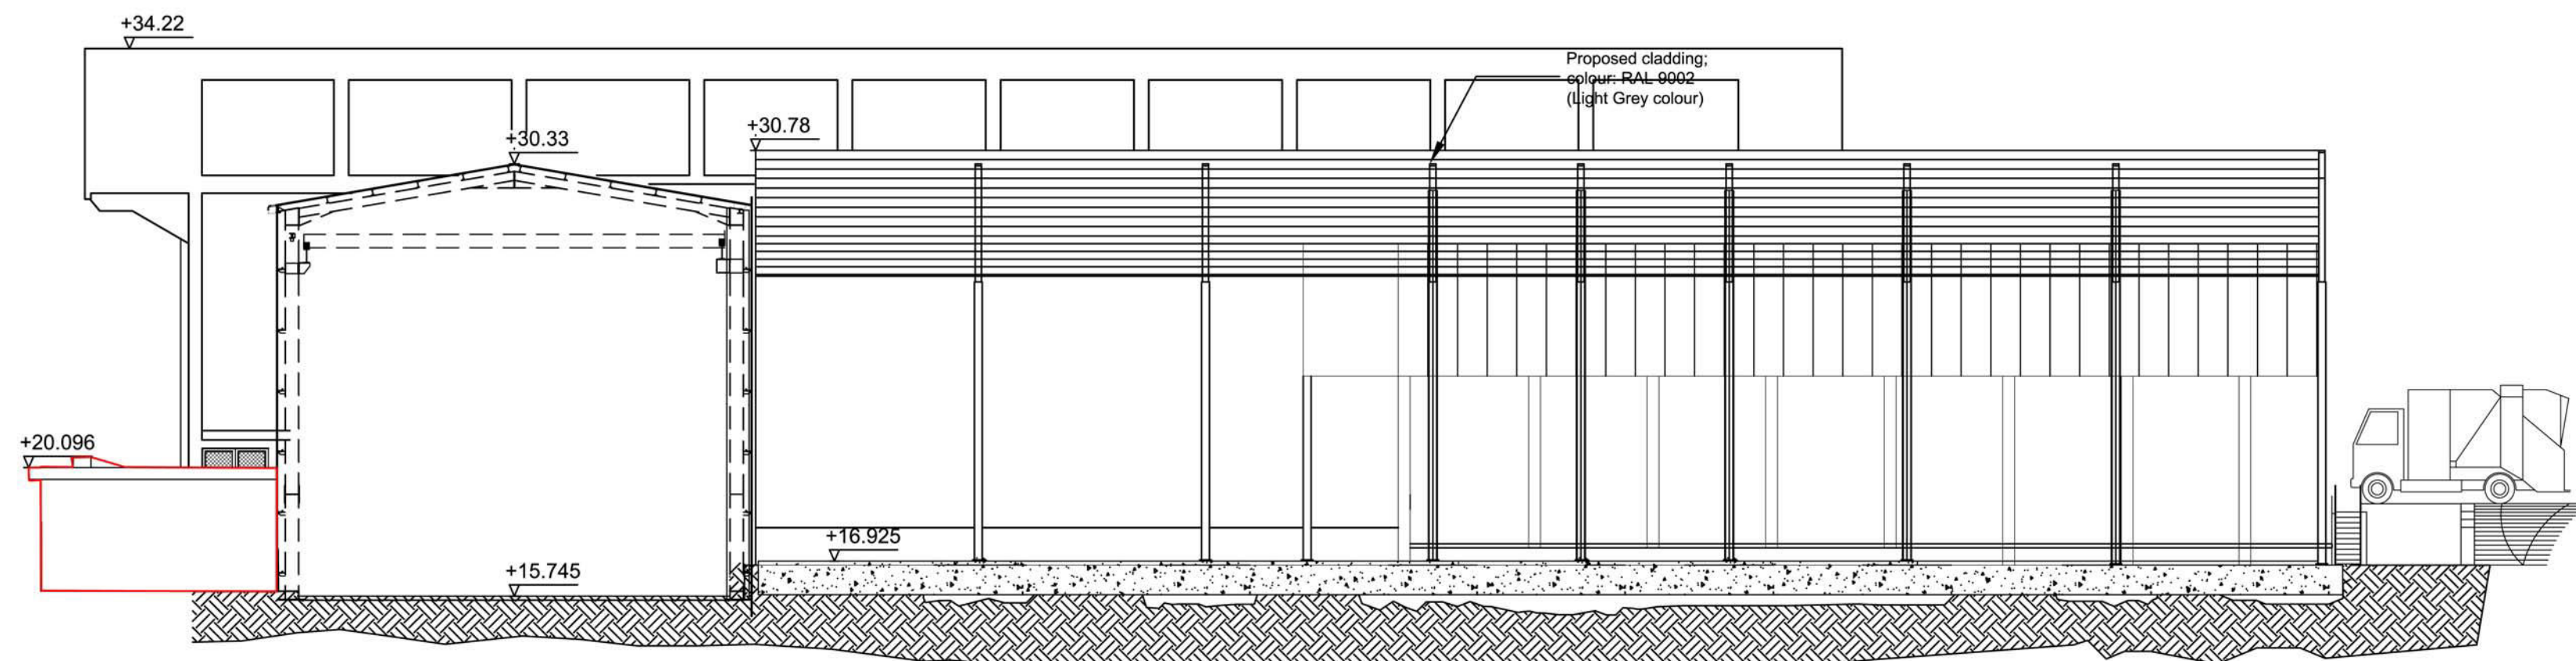


SECTION - XX

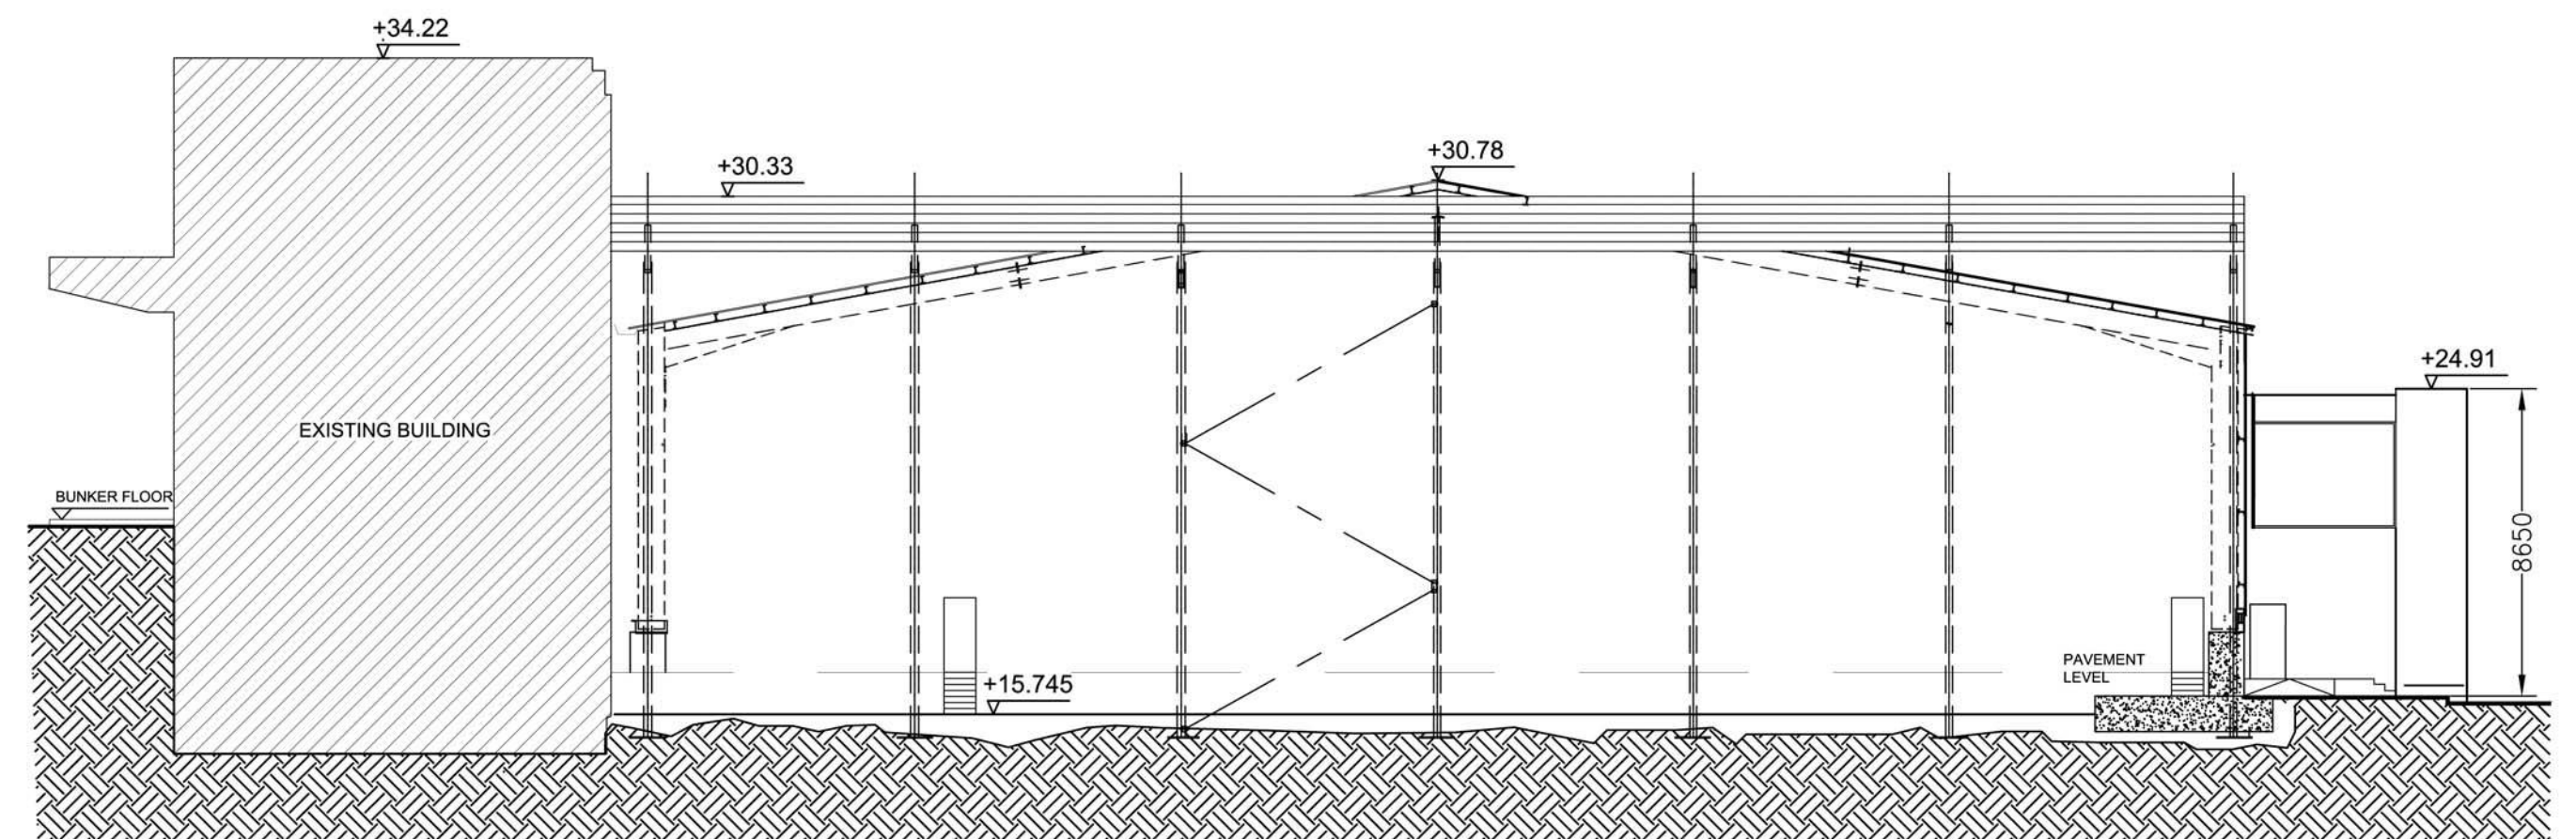


SECTION - YY

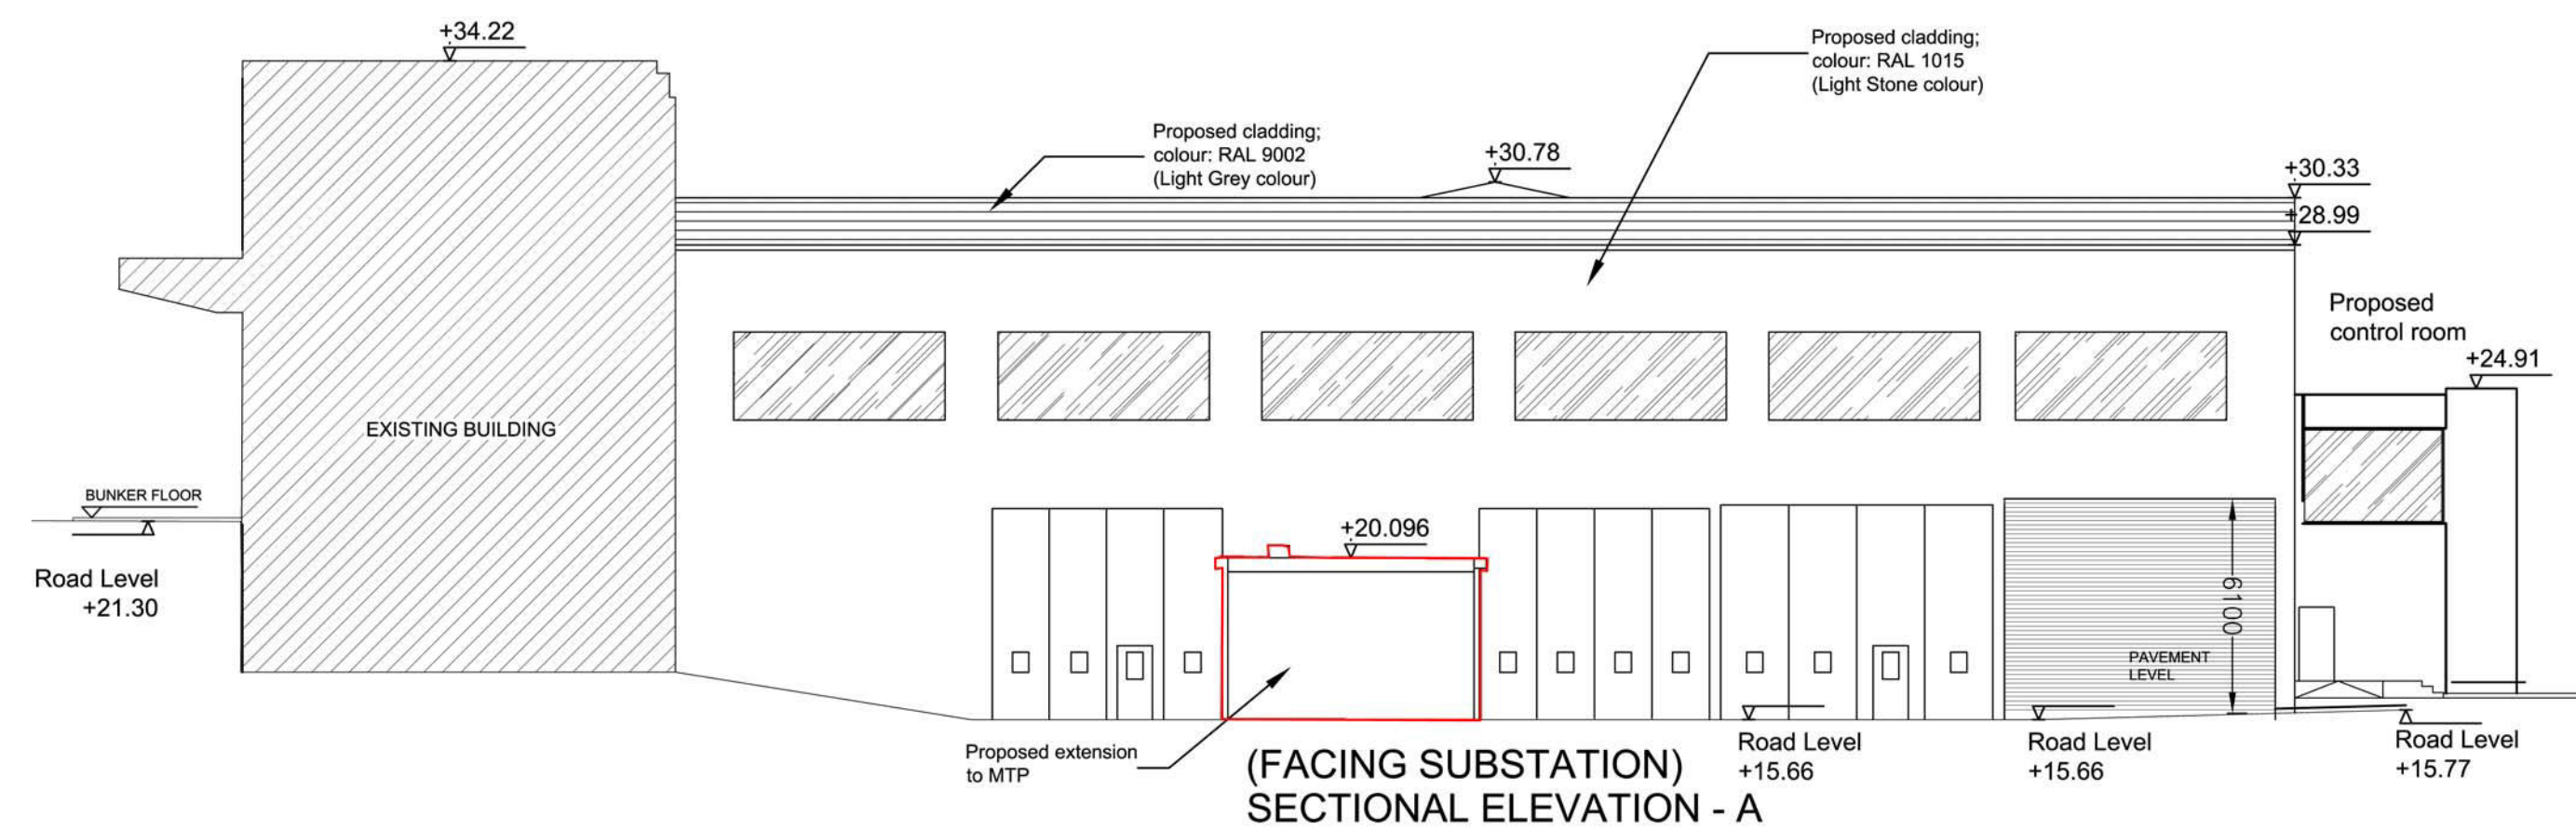


(FACING SUBSTATION)
SECTIONAL ELEVATION - A

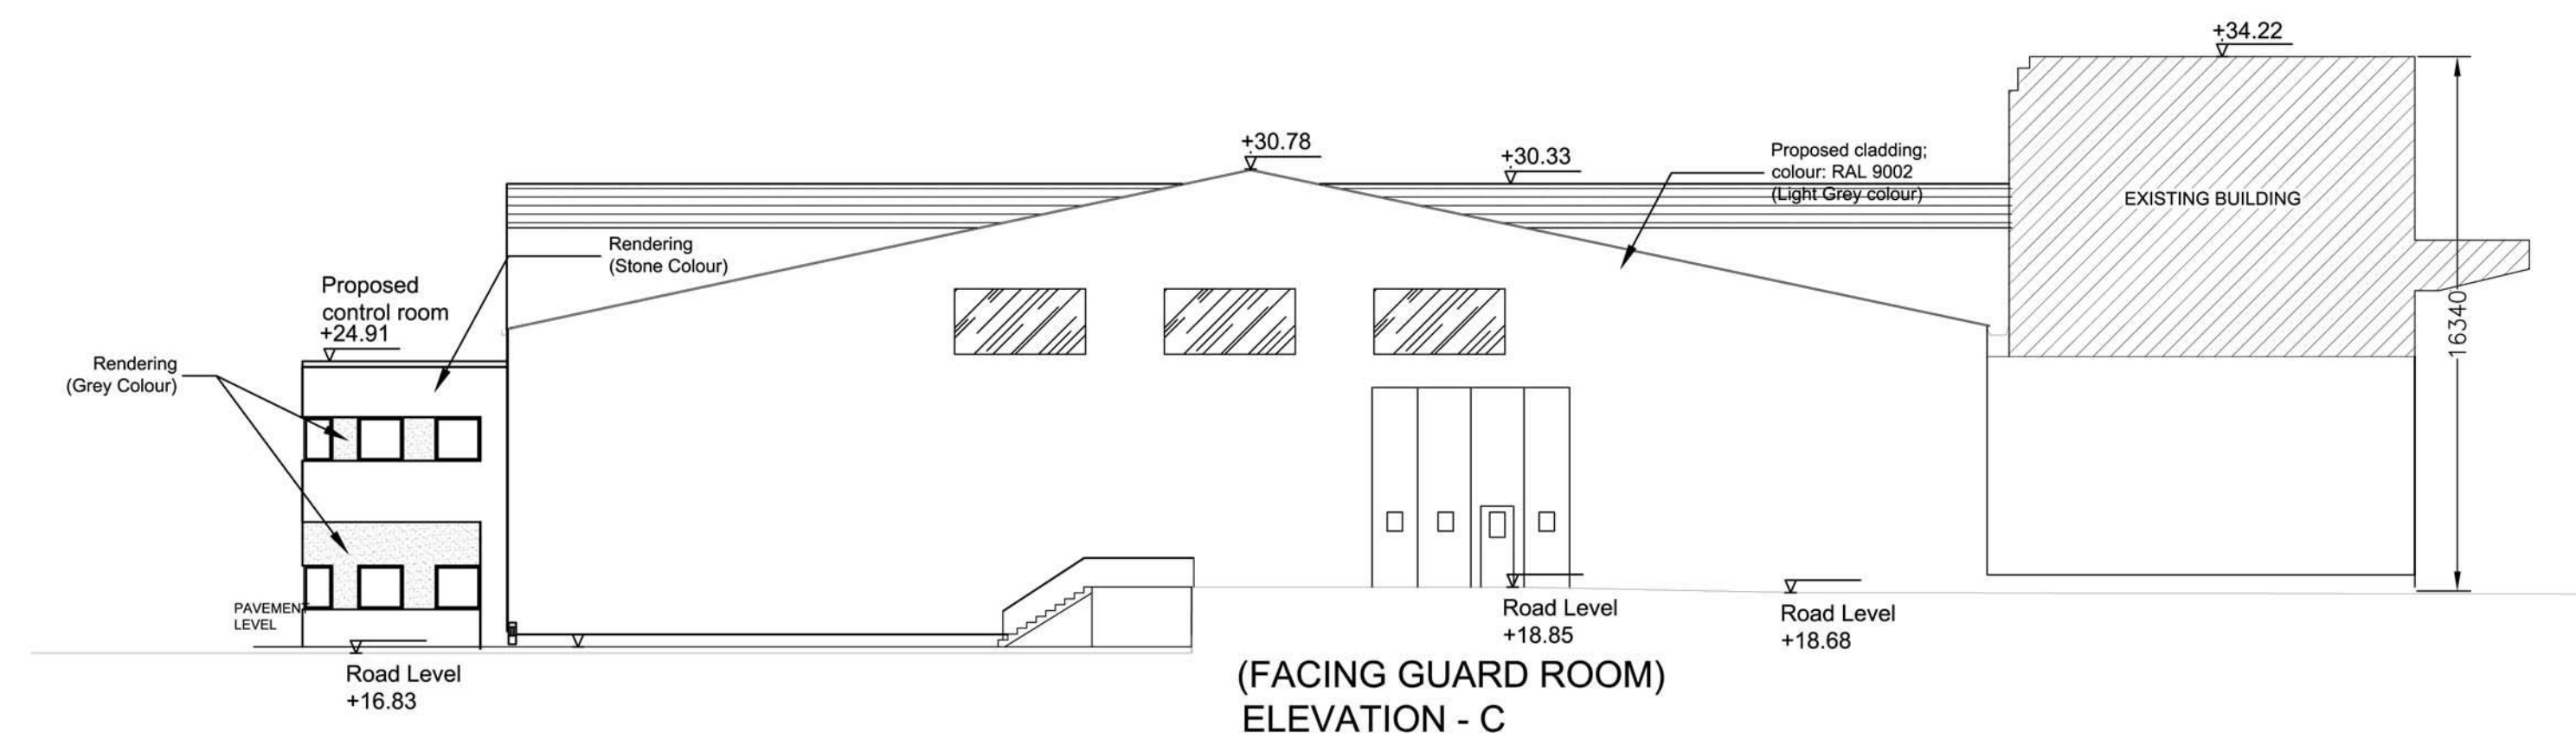


(FACING GUARD ROOM)
ELEVATION - C

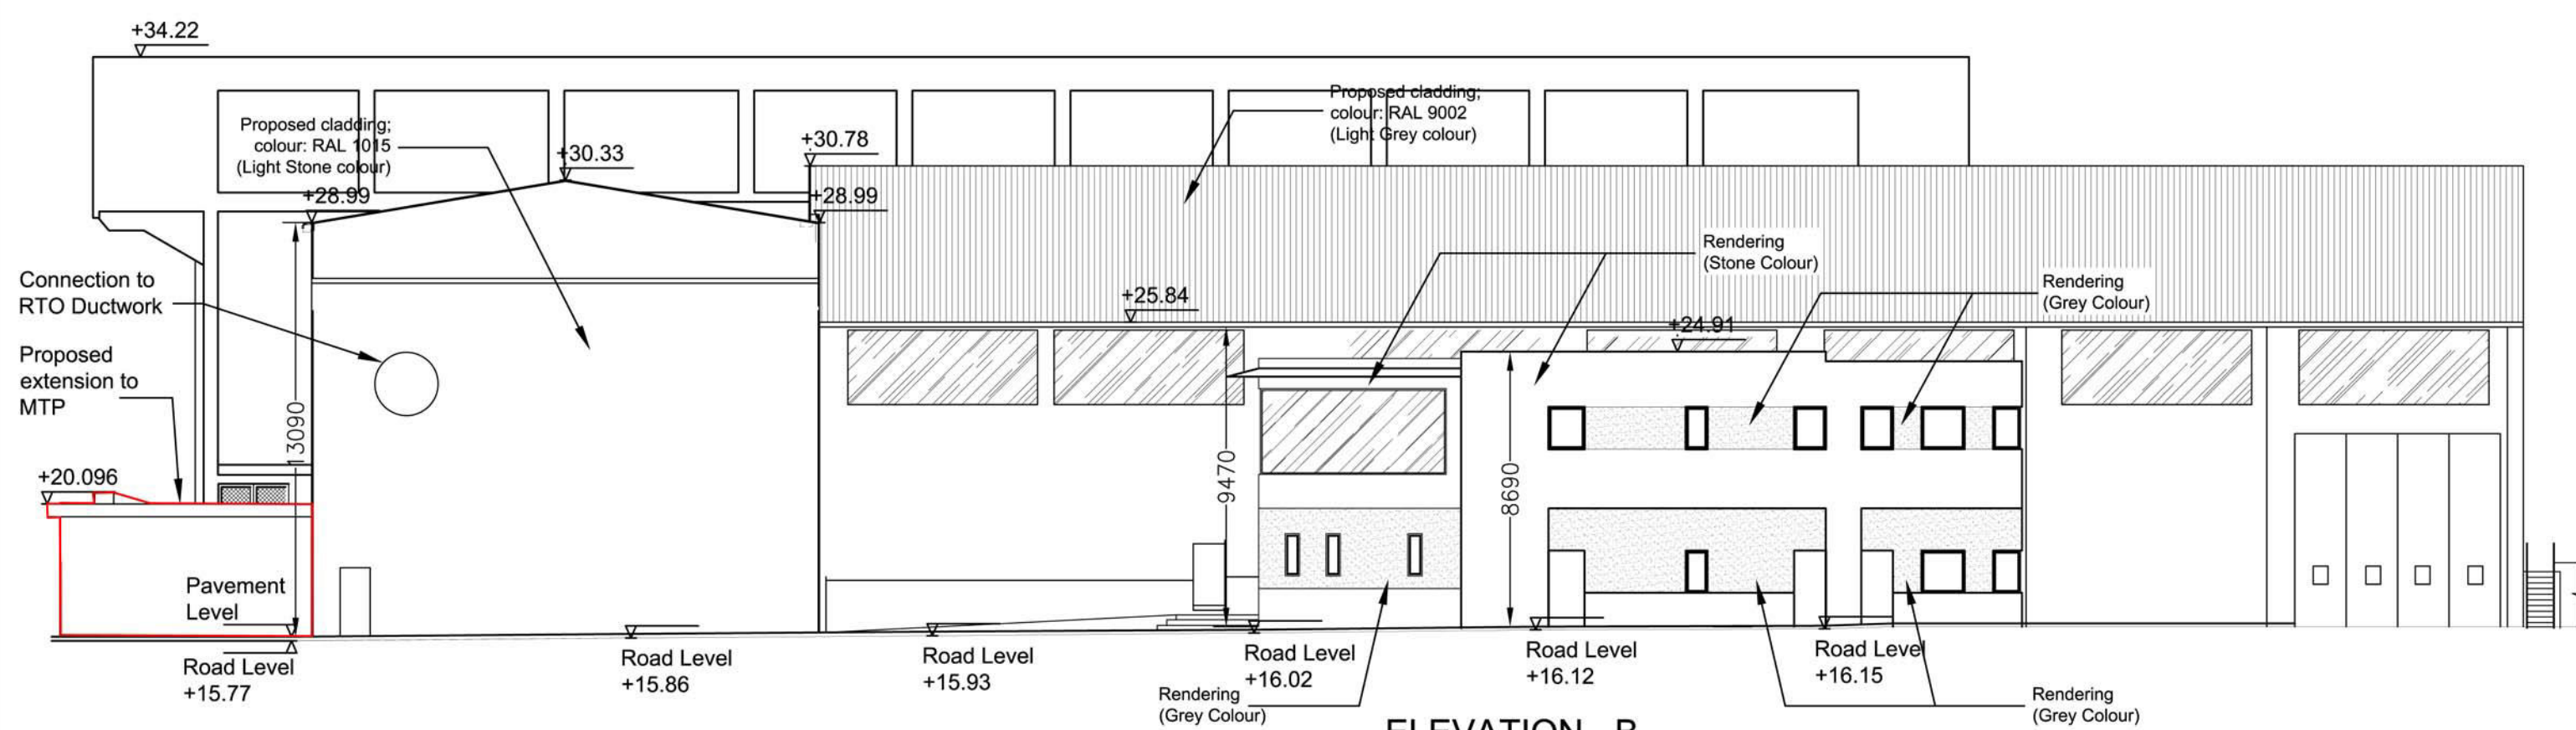

ELEVATION - B
(FACING MRF)

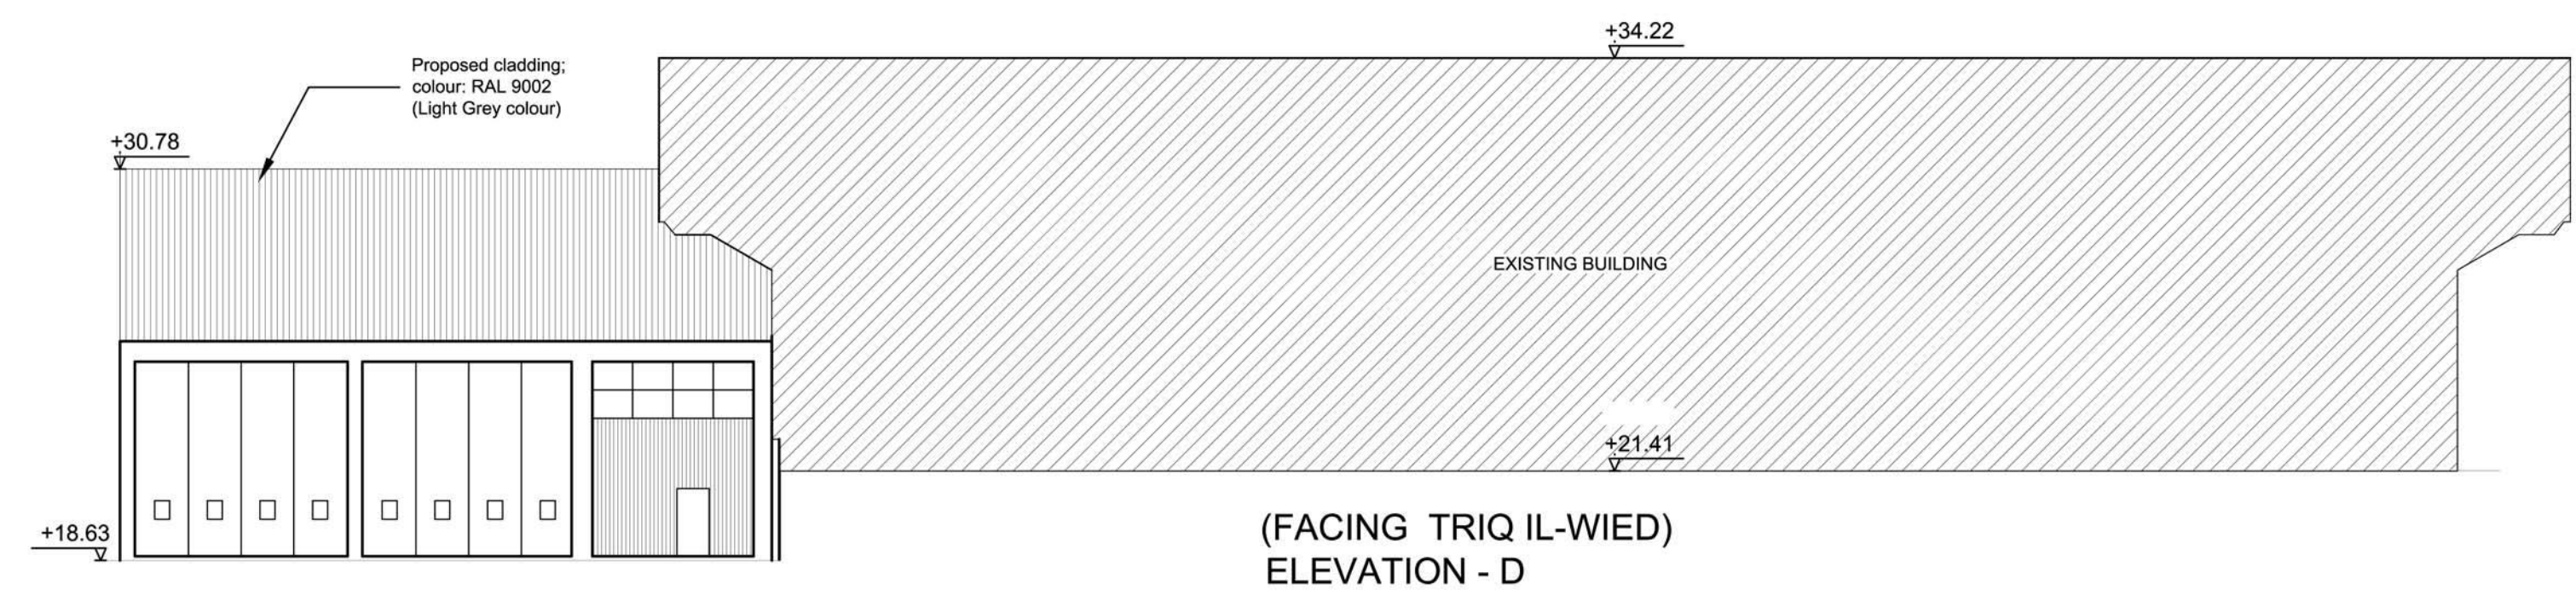

(FACING TRIQ IL-WIED)
ELEVATION - D

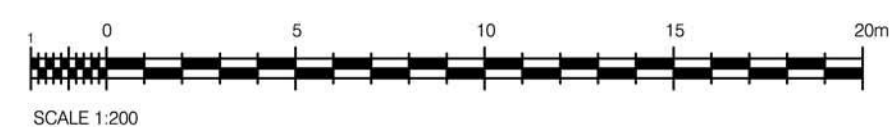

FOR MEPA

D	20/06/2012	L.B.	Extension to MTP
C	12/12/11	L.B.	General Amendments
B	11/10/11	R.M.	General Amendments
A	16/06/10	R.M.	General Amendments
No.	Date	Initials	Revision Details


BEZZINA & COLE
ARCHITECTS & ENGINEERS

52, St. Augustine Bartolo Street, Ta' Xbiex, MSD11 MALTA
Tel. (356) 21310966, Telefax (356) 21311800

Job Title
**SANT ANTNIIN WASTE
MANAGEMENT FACILITY**

Drawing Title
**AS BUILT SECTIONS & ELEVATIONS
FOR THE MECHANICAL TREATMENT
PLANT
(MTP)**

Job No. 17-05	Drwg. No. AL(2_)45D
File Path MEPA-10	
Scale 1:200	Drawn R.MUSCAT
Date 04-08-06	Checked K.AGIUS

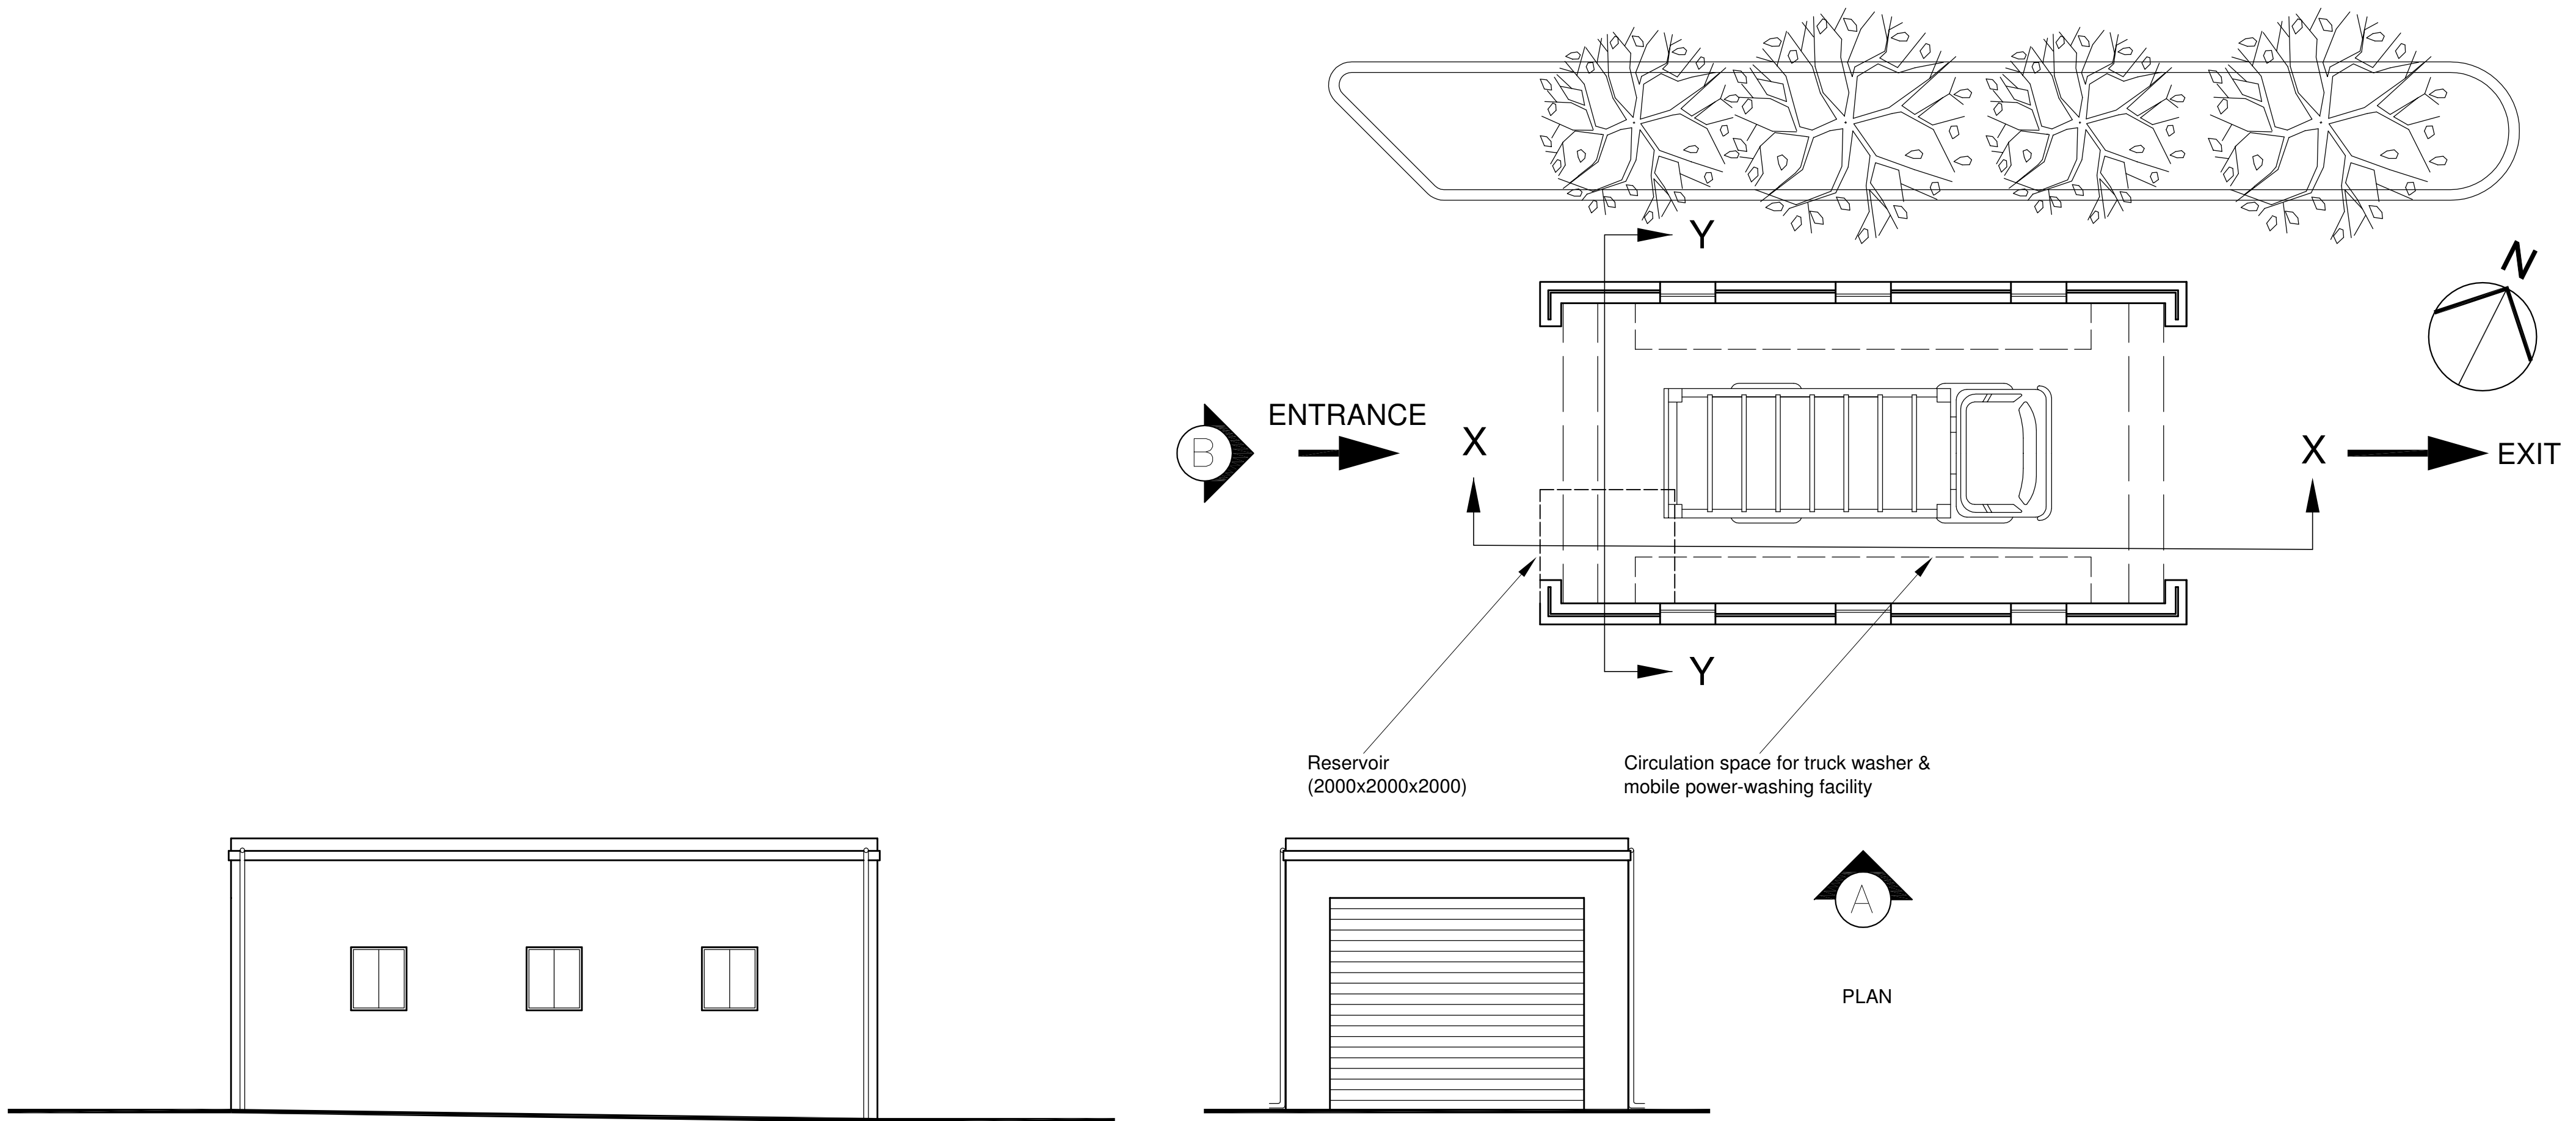

ELEVATION A

ELEVATION B

PLAN

SECTION XX

SECTION YY

MEPA 2010

No.	Date	Initials	Revision	Details
BEZZINA & COLE ARCHITECTS & ENGINEERS 52, Sir Augustus Bartolo Street, Ta'Xbiex, MSD11 MALTA Tel. (356) 21310966, Telefax (356) 21311800				
Job Title SANT ANTIN WASTE MANAGEMENT FACILITY				
Drawing Title PLAN, ELEVATIONS AND SECTIONS OF TRUCK WASHING FACILITY				
Job No. 17-05		Drwg. No. AL(2_)46		
File Path MEPA-10				
Scale 1:100	Date 04-08-05	Drawn R.ZAMMIT	Checked K.AGIUS	