




EP 00343/25 - 58B - Jasmine Baldacchino - 02/03/2026 09:42:02

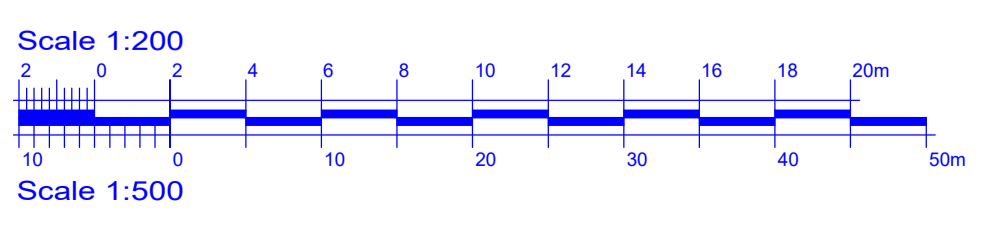

LEGEND	

GENERAL NOTES		REVISIONS		
nr.	description	rev	date	Details
0	0	0	0	0

CLIENT:		JOB TITLE:	
WASTESERV CREATING RESOURCES FROM WASTE		CA Site - Ta'Qali	
DRAWING TITLE			
As Built - General Plan Ta'Qali			
scale	date	file no.	dwg no.
1:200 on A1	24/09/2025	WSM 041	01
drawn	checked	revision suffix	
CS			
WASTESERV MALTA LTD.			