


EP 00347/25 - 30G - Jasmine Baldacchino - 02/03/2026 11:08:43

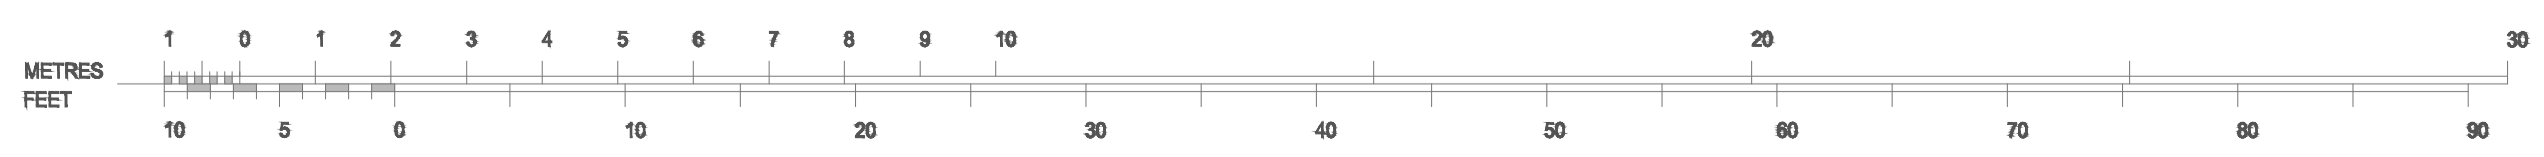

SCALE 1:100

GENERAL NOTES		REVISIONS		
nr.	description	rev	date	Details

CLIENT:		JOB TITLE:	
<b>WASTESERV</b> CREATING RESOURCES FROM WASTE		CA Site - Magtab	
DRAWING TITLE			
As Built - General Plan Magtab			
scale	date	file no.	dwg no.
1:200 on A1	25/09/2025	WSM 041	01
drawn	checked	revision suffix	
CS			
WASTESERV MALTA LTD.			