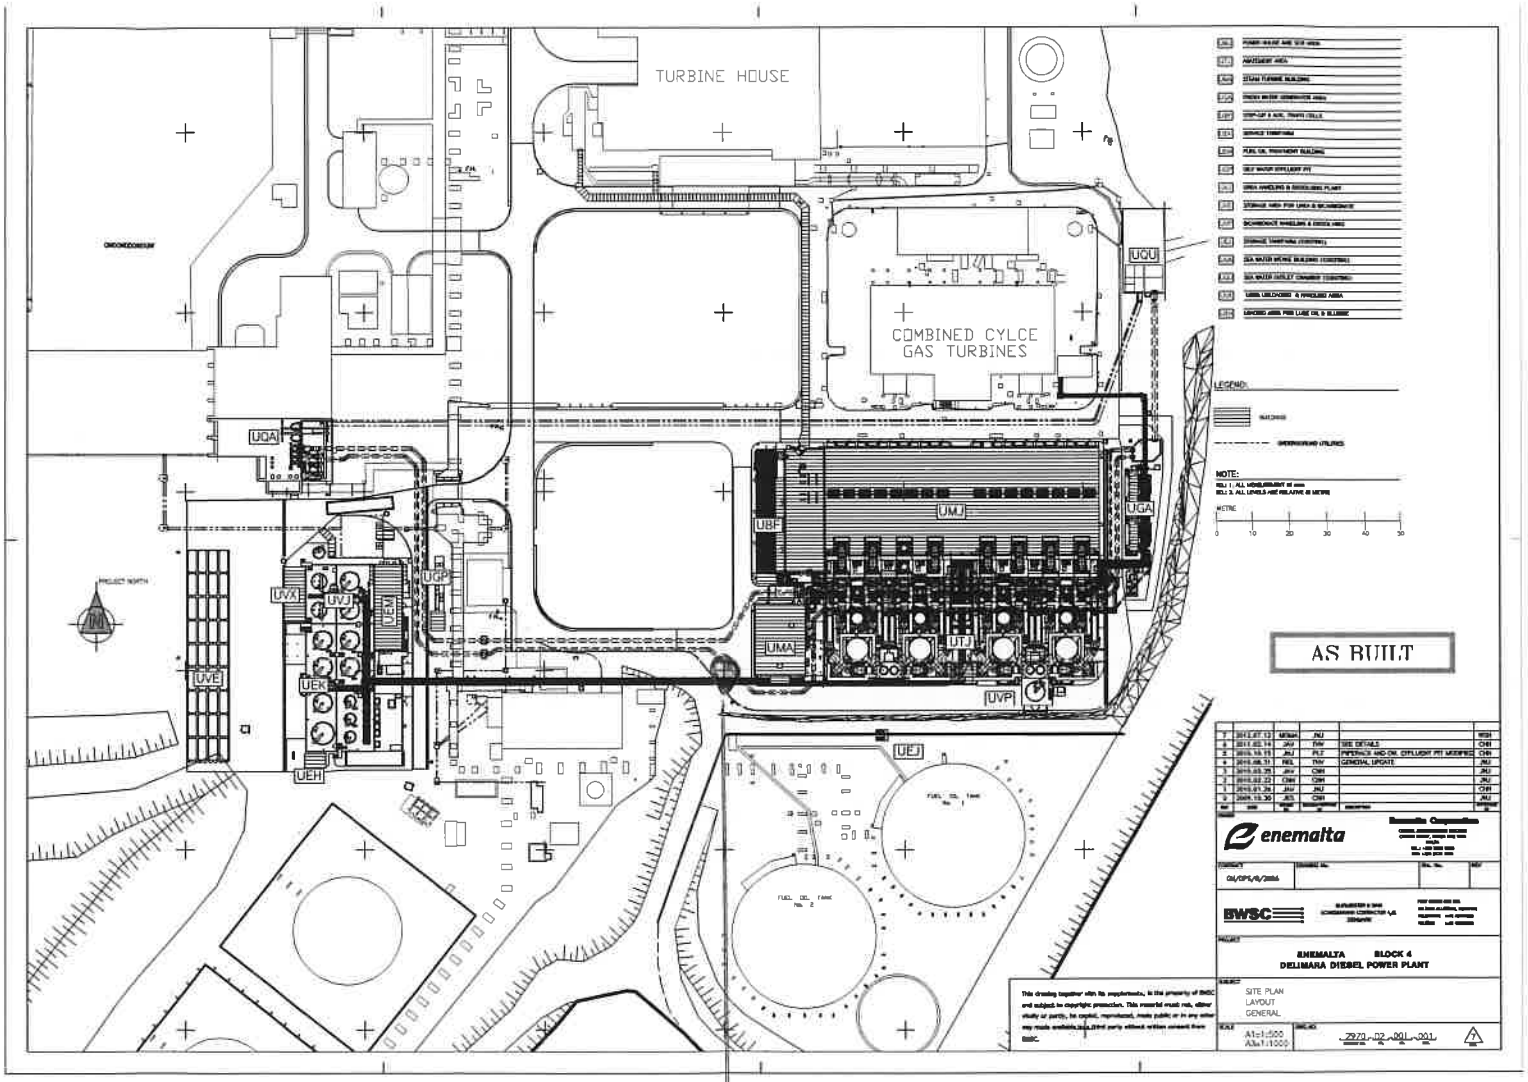
TURBINE HOUSE
COMBINED CYLCE
GAS TURBINES
UQU
UQA
UBF
UMJ
UGA
UGP
UVX
UVJ
UEM
UMA
UTJ
UVE
UEK
UVP
UEJ
UEH
LEGEND:
NOTE:
AS BUILT
enemalta
BWSC
ENEMALTA BLOCK 4
DELIMARA DIESEL POWER PLANT
SITE PLAN
LAYOUT
GENERAL
A1=1:500
A3=1:1000
7970 - 02 - 001 - 001

F1 | FB1