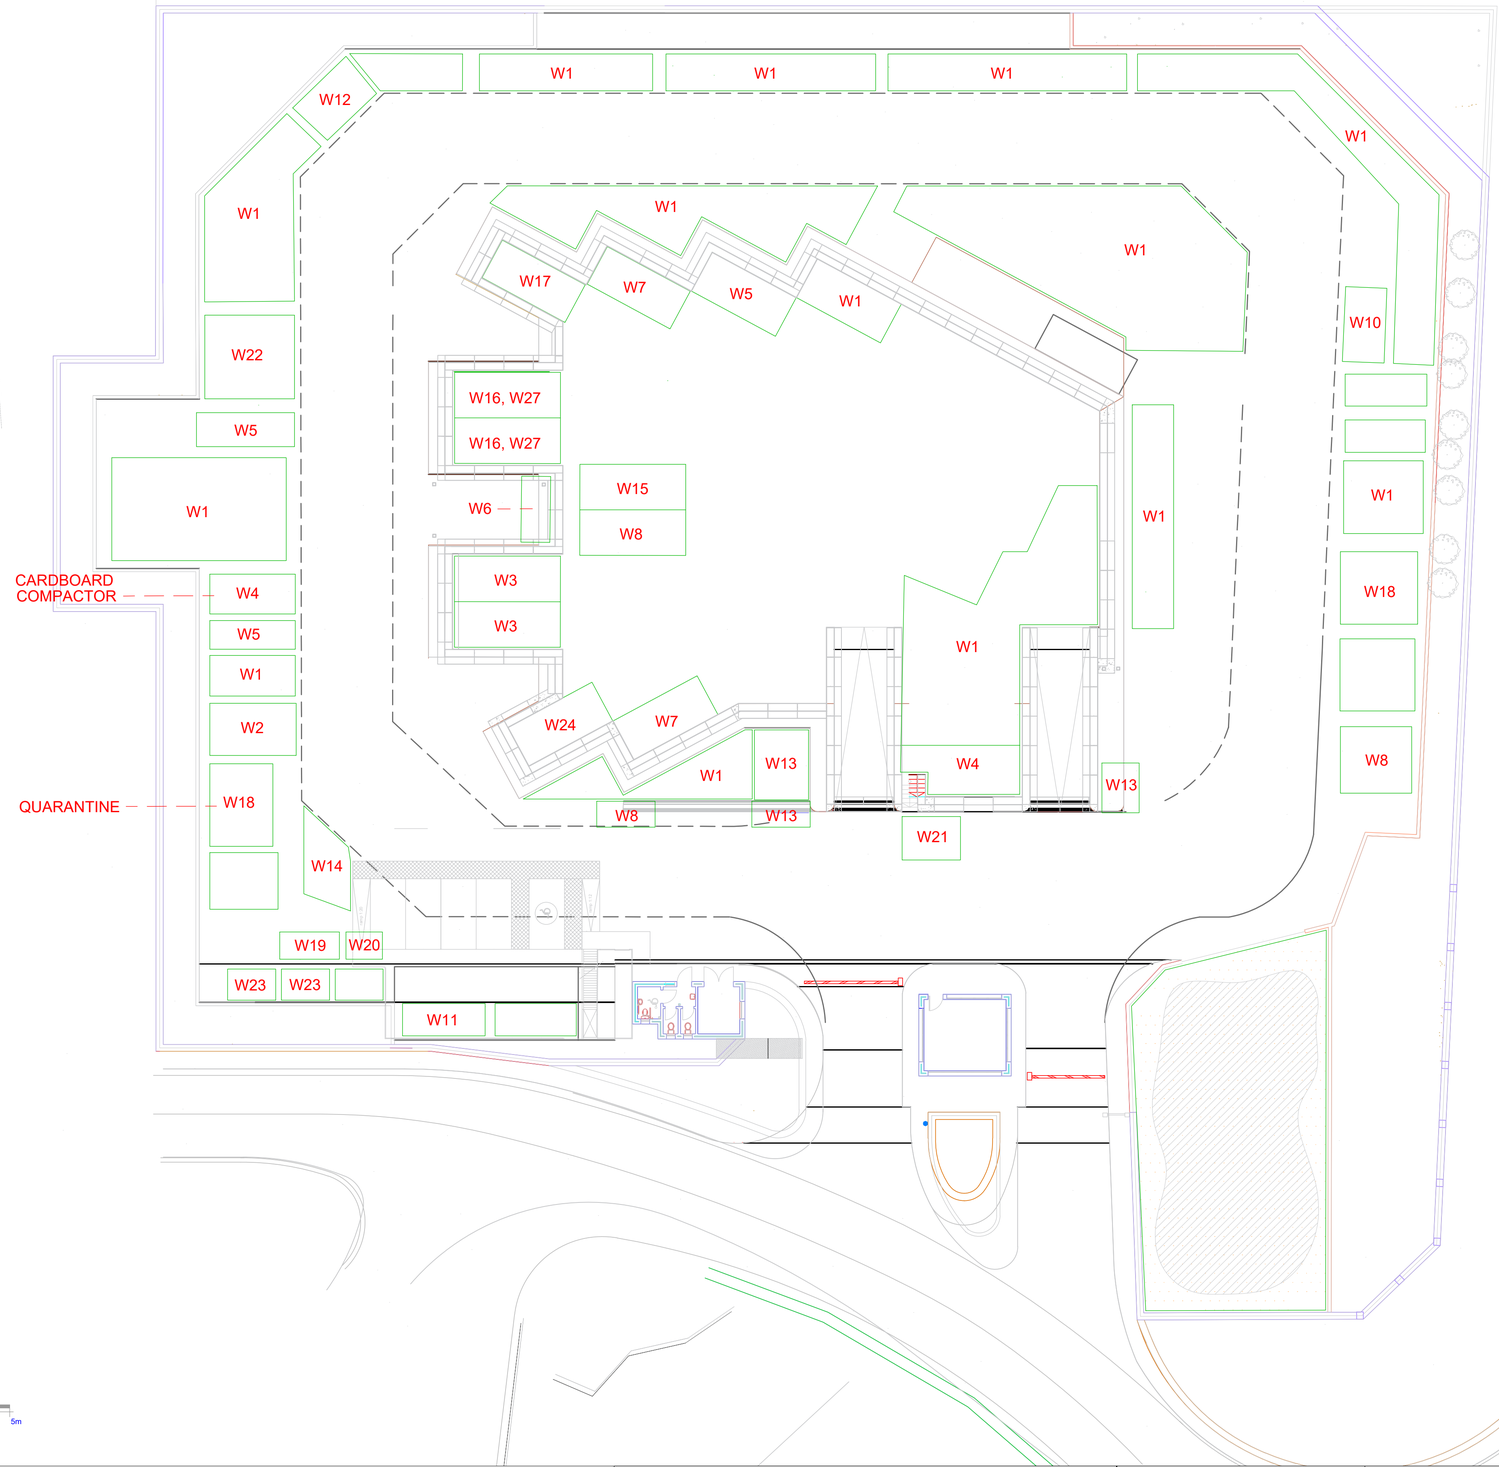

EP 00348/25 - 30L - Jasmine Baldacchino - 02/03/2026 11:09:00

Scale 1:250

2.5 0 2.5 5 7.5 10 12.5 15 17.5 20 22.5 25m

1 0 1 2 3 4 5m

Scale 1:50

LEGEND

GENERAL NOTES

nr.	description
0	0

REVISIONS

rev	date	Details
0	0	0

CLIENT:

WASTESERV
CREATING RESOURCES FROM WASTE

WASTESERV MALTA LTD.

JOB TITLE:

The Construction of a
Civic Amenity Facility at Luqa

DRAWING TITLE

As Built - General Plan
Luqa

scale	date	file no.	dwg no.
1:250 on A1	11/03/2025	WSM 041	01

drawn	checked	revision suffix
CS		